

**Jimerson**  
 COUNTY WELL LOCATED  
**LAWRENCE**  
 WELL NUMBER: **N-2050** CODED  
 DATE WELL COMPLETED: **7-20-99**

PERMIT NUMBER: **0-586**  
 NAME OF DRILLING FIRM: **James Wells**  
 Water Well Ser

**MISSISSIPPI DEPARTMENT OF ENVIRONMENTAL QUALITY**

Office of Land and Water Resources

P. O. Box 10631  
 Jackson, MS 39289-0631  
**WATER WELL DRILLERS LOG**

NAME & MAILING ADDRESS OF LANDOWNER: **Roy Berry**  
**P.O. Box 44**  
**New Hebron ms 39140**  
 WELL LOCATION: SEC **12** TOWNSHIP **19** RANGE **12**  
 DISTANCE: **3** Miles DIRECTION: **North** of **New Hebron**  
 OTHER LANDMARK  
 WELL PURPOSE: Home Irrigation, Municipal, Industrial, Fish Pond, etc.

**PUMP DATA**  
 PUMP TYPE (Circle One):  
 Submersible, Turbine, Jet, Flowing Well,  
 Other (Describe) **HAND Pump**  
 POWER TYPE (Circle One):  
 Electric, Tractor, Diesel, Gasoline, Butane,  
 Other (Describe) **H/P**  
 Pump Capacity (GPM) No. of Stages Setting Depth FT.  
**PUMP TEST**  
 Well yielded **5** GPM with  
 a drawdown of \_\_\_\_\_ ft.  
 after \_\_\_\_\_ hours of pumping

**WELL DATA**  
 Well Depth **60** Casing Diameter (In.) **2in** Casing Length (Ft.) **50**  
 Type of Casing **PVC** Hole Depth **60** Depth to Static Water Level **15**  
 TYPE OF COMPLETION: (Circle One or More):  
~~Gravel Packed~~ Underreamed, Telescoped,  
 Natural Development, Open Hole, Other  
 (Describe)  
 WELL GROUTED TO A DEPTH OF **16** FEET  
 Type Grout (circle one): Cement, Bentonite, or Mix

**LOG DATA**  
 TYPE OF LOG RUN (Circle One): No Log Run, Electric, Gamma Ray, Density, Sonic, Neutron, Other (Describe)  
 Name of Organization Running Log

**SCREEN DATA**  
 Diameter - Inches **2** Length - Feet **16** Slot Size - Inches **8"**  
 Screen Type **PVC** Depth to Bottom - Feet **50-60**

**GEOLOGIC DATA (Office Use Only)**

Surface Elev.	Geologic Unit	Unit Thickness	Depth to Top
Subs. SWL	Date	Analysis	Aquifer Test

Driller's Remarks  
 Top of Lap Pipe or Reduction in Casing  
**FEET** IF TELESCOPED OR MORE THAN ONE SCREEN: USE BACK PAGE

DESCRIPTION OF FORMATIONS ENCOUNTERED	FROM	TO	FORMATIONS (Continued)	FROM	TO
<b>Top Soil</b>	<b>0</b>	<b>2</b>			
<b>clay</b>	<b>2</b>	<b>15</b>			
<b>Sand</b>	<b>15</b>	<b>60</b>			

**JUL 20 2000**  
 Dept of Environmental Quality  
 Office of Land & Water Resources

IF MORE SPACE IS NEEDED, USE BACK


If well telescopes please  
sketch and show depths.

GROUND LEVEL


SECTION \_\_\_\_\_

Please indicate well location X.

ADDITIONAL INFORMATION

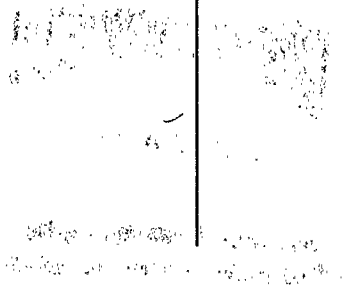

If more than one screen,  
show location of each on sketch.