

SIMPSON MISSISSIPPI BOARD OF WATER COMMISSIONERS

05
7-12-62

WATER WELL DRILLERS LOG

CODED

Date: 7/12, 1962, Driller: Walter Roberts County Simpson
(Name)

(1) Owner of Land: W.A. Manchester
(Name)
Shivers, Miss
(Address)

(2) Location: 1/4, 1/4, Sec. 20 T10R20
4 miles E, of Shivers
(distance) (direction) (Nearest Town)

(3) Topography: X
(Hilly) (Flat) (Level)

(4) Purpose of Well:
(Domestic Irrigation
Municipal, Industrial, Other)

Description & Color of Materials Sand, Clay, Red Clay, Shell, etc.	Thick- ness Feet	Depth Feet
<u>Red Clay</u>	<u>20</u>	<u>20</u>
<u>white chalk</u>	<u>22</u>	<u>42</u>
<u>Sand</u>	<u>42</u>	<u>84</u>
<u>weather sand</u>	<u>5</u>	<u>89</u>

Information upon completion of well:


- (1) Diameter 2 inches.
(2) Total Depth 89 feet.
(3) Water Level 84 feet below top of ground.
(4) Cased to 85, Size 2"
(5) Screen: Size 1/4, Length 4 ft
(6) Were any formations sealed against pollution?
_____ yes, _____ no.

If YES depth of formation _____

Why _____

Drillers Remarks: _____

CODED

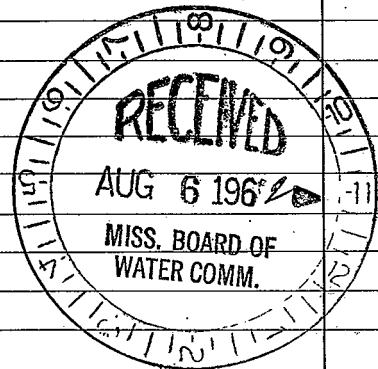

(Use Back Side)

Well No.

[The page contains extremely faint and illegible text, likely bleed-through from the reverse side of the document. No specific content can be transcribed.]