

GW01775

13N

Elog #97

CODED

SIMPSON
07
8-1-68
Miss. Geo. Surv.

MISSISSIPPI
BOARD OF WATER COMMISSIONERS
416 North State Street
Jackson, Mississippi 39201

CODED CODED

CODED

WATER WELL DRILLERS LOG

8-1-1968 date well completed
168 Leeper-Central Co. firm name
Simpson county well located

LANDOWNER: Highway 28
Rural Water Association
Magee, Miss.
(mailing address)

description of formations encountered	from	to
Hard Red Clay	0	15'
Sandy Clay	15	25
Loose Sand	25	51
Clay with Sand streaks	51	111
Sand and leaf litter	111	155
Clay (brick)	155	159
Sand and Peas Gravel	159	191
Sand and Peas Gravel	191	206
Clay	206	240
Hard Clay and Gravel Str.	240	285
Rock	285	286
Hard Shale	286	354
Rock	354	358
Shale and Sand streaks	358	370
Loose Sand and Clay streaks	370	420
Clay	420	463
Shale	463	470
Blue Clay	470	600
Hard Shale	600	605
Sand	605	618
Rock	618	619
Shale and Sand streaks	619	741
Hard Shale	741	785
Sandy Shale	785	809


WELL LOCATION:
sec 13 T 10 N R 19 E
SW-SW
miles of (distance) (direction) (nearest town)

WELL PURPOSE: Domestic
(home, irrigation, municipal, industrial)

WELL COMPLETION DATA:

- (1) diameter (inches) 10"
- (2) total depth (feet) 204'
- (3) static water level (feet) 125' below top of ground.
- (4) casing steel, 179' (material) (depth)
10" (size) if telescope see back.
- (5) screen 20' (length), 179' (depth to top)
8" (size), Stainless Steel (material)
- (6) pump 20 (HP) (yield gpm)
Electric (type power)
- (7) electric log YES (yes or no)
Miss. Geo. Survey (organization running log)
- (8) how well bottom plugged valve


DRILLERS REMARKS:
No test run as of this date
Pumping test by USGS

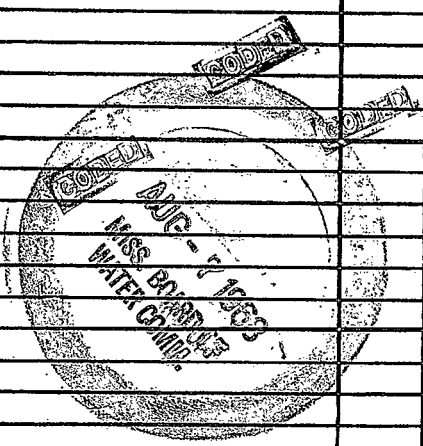

Elev. 552

If well telescopes please sketch and show depths.

GROUND LEVEL

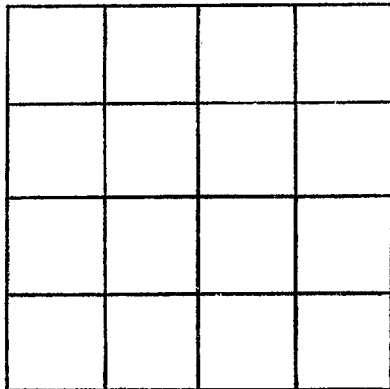

SECTION _____

Please indicate well location X.

ADDITIONAL INFORMATION

If more than one screen, show locations of each on sketch.