

MISSISSIPPI  
BOARD OF WATER COMMISSIONERS  
416 North State Street  
Jackson, Mississippi 39201

CODED

WATER WELL DRILLERS LOG

Simpson  
Ø 9'  
2-2-70

SIMPSON  
~~JEFFERSON~~  
county well located

2-2-1970 PRENTISS BUTAKE  
date well completed firm name

LANDOWNER:	description of formations encountered	from	to
M. J. LONGINO	ROCKS + GRAVEL	0	122
NEW HEBRON (mailing address)			
WELL LOCATION:			
sec. 25 T. 10 N. R. 19 E.			
2 miles E of SHIVERS (distance) (direction) (nearest town)			
WELL PURPOSE: (home, irrigation, municipal, industrial)			
WELL COMPLETION DATA:			
(1) diameter (inches) 2"			
(2) total depth (feet) 122			
(3) static water level (feet) 100 below above top of ground.			
(4) casing GALV, 119 (material) (depth)			
_____ if telescope see back. (size)			
(5) screen 3 - 119 (length) (depth to top)			
2, S.S. (size) (material)			
(6) pump 1 500 (HP) (yield gpm)			
E (type power)			
(7) electric log _____ (yes or no)			
_____ (organization running log)			
(8) how well bottom plugged B.W.V			

CODED


MAR 9 1970

MISS. BD. OF  
WATER COMM.

DRILLERS REMARKS:

If well telescopes please sketch and show depths.

GROUND LEVEL

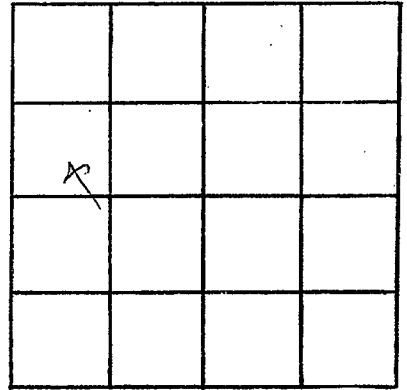

SECTION 25

Please indicate well location X.

ADDITIONAL INFORMATION

If more than one screen,  
show locations of each on sketch.