

MISSISSIPPI
BOARD OF WATER COMMISSIONERS
416 North State Street
Jackson, Mississippi 39201

COPIED

WATER WELL DRILLERS LOG

Ø 13
SIMPSON
6-26-73

June 26 1973 K. E. Thompson Simpson
date well completed firm name county well located

LANDOWNER:
Lockport Farm

(mailing address)

description of formations encountered	from	to
<u>Top Soil</u>	<u>0</u>	<u>10</u>
<u>White Sand</u>	<u>10</u>	<u>105</u>
<u>Gravel</u>	<u>105</u>	<u>115</u>
<u>Sand</u>	<u>115</u>	<u>120</u>

WELL LOCATION:
sec. 34 T. 10 (N) S. R. 19 E. (W)
4 1/2 miles S of Meridian
(distance) (direction) (nearest town)

WELL PURPOSE: Drinking
(home, irrigation, municipal, industrial)


- WELL COMPLETION DATA:
- diameter (inches) 4"
 - total depth (feet) 170
 - static water level (feet) 105 below above top of ground.
 - casing Plasted, 160,
(material) (depth)
4"
(size) if telescope see back.
 - screen 10' 160
(length) (depth to top)
4", Plasted
(size) (material)
 - pump 1 1/2 30
(HP) (yield gpm)
700
(type power)
 - electric log no
(yes or no)
- (organization running log)
- (8) how well bottom plugged _____

DRILLERS REMARKS: _____

AUG 13 1973

If well telescopes please sketch and show depths.

GROUND LEVEL

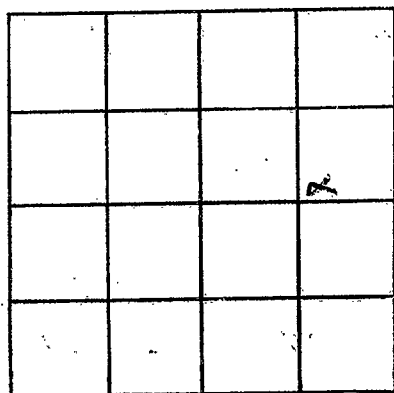

SECTION 24

Please indicate well location X.

ADDITIONAL INFORMATION

If more than one screen, show locations of each on sketch.