

SIMPSON
Φ 14
6-26-73

MISSISSIPPI
 BOARD OF WATER COMMISSIONERS
 416 North State Street
 Jackson, Mississippi 39201

CODED

WATER WELL DRILLERS LOG

June 24 1973 H. E. Thompson Simpson
 date well completed firm name county well located

LANDOWNER:	description of formations encountered	from	to
<u>E. O. Lockhart</u>			
<u>Mendenhall miss</u> (mailing address)	<u>Red sand.</u>	<u>10</u>	<u>105</u>
WELL LOCATION:	<u>gravel.</u>	<u>105</u>	<u>115</u>
sec <u>34</u> T <u>10</u> N R <u>19</u> E W	<u>sand.</u>	<u>115</u>	<u>170</u>
<u>4 1/2</u> miles <u>S</u> of <u>Merib.</u>			
(distance) (direction) (nearest town)			
WELL PURPOSE: <u>Drain</u> (home, irrigation, municipal, industrial)			
WELL COMPLETION DATA:			
(1) diameter (inches) <u>4"</u>			
(2) total depth (feet) <u>170'</u>			
(3) static water level (feet) <u>105'</u> below top of ground.			
(4) casing <u>4" pipe, 160'</u> (material) (depth)			
<u>4"</u> If telescope see back. (size)			
(5) screen <u>10" 160'</u> (length) (depth to top)			
<u>610</u> , <u>Aluminum</u> (size) (material)			
(6) pump <u>1 1/2</u> <u>30</u> (HP) (yield gpm)			
<u>Sub.</u> (type power)			
(7) electric log <u>no</u> (yes or no)			
(organization running log)			
(8) how well bottom plugged <u>plugged</u>			
DRILLERS REMARKS:			


CODED

NEW 6 1973

MISS. BD. OF
 WATER COM.

If well telescopes please sketch and show depths.

GROUND LEVEL

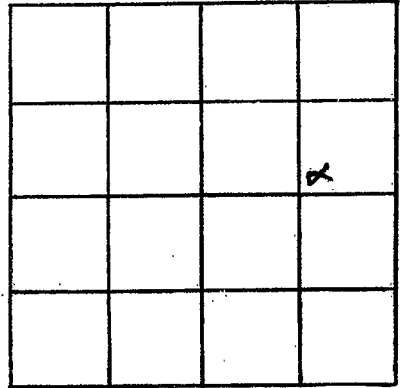

SECTION 34

Please indicate well location X.

ADDITIONAL INFORMATION

If more than one screen, show locations of each on sketch.