

SIMPSON
Ø 16
9-14-78
E Log # 220
9-14-

MISSISSIPPI
 BOARD OF WATER COMMISSIONERS
 416 North State Street
 Jackson, Mississippi 39201

CODED

WATER WELL DRILLERS LOG

19 78 General Waterwell SIMPSON

date well completed

firm name

county well located

LANDOWNER:	description of formations encountered	from	to
<u>VERA BARRETT</u>			
(mailing address)			
WELL LOCATION:			
sec. <u>17</u> T. <u>10</u> N. R. <u>14</u> E.			
S W W			
(distance) miles (direction) of (nearest town)			
WELL PURPOSE: (home, irrigation, municipal, industrial)			
WELL COMPLETION DATA:			
(1) diameter (inches) <u>4.0</u>			
(2) total depth (feet) <u>135</u>			
(3) static water level (feet) <u>110</u> below top of ground.			
(4) casing <u>PVC</u> <u>115</u> (material) (depth)			
<u>4</u> if telescope see back. (size)			
(5) screen <u>20</u> <u>115</u> (length) (depth to top)			
<u>4</u> <u>PVC</u> (size) (material)			
(6) pump <u>1/2</u> <u>5</u> (HP) (yield gpm)			
(type power)			
(7) electric log (yes or no)			
(organization running log)			
(8) how well bottom plugged <u>BWV</u>			
DRILLERS REMARKS:			


CODED

RECEIVED
 OCT 25 1978

MISS. BD. OF WATER COMMISSIONERS

If well telescopes please
sketch and show depths.

GROUND LEVEL

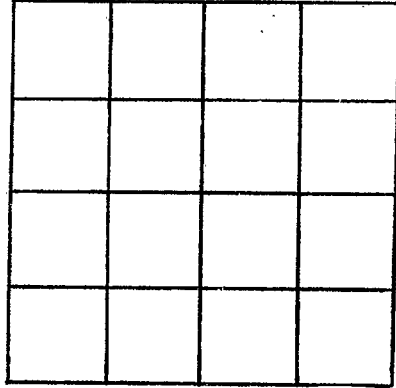

SECTION _____

Please indicate well location X.

ADDITIONAL INFORMATION

If more than one screen,
show locations of each on sketch.