

SIMPSON
 19
 5/16/79

MISSISSIPPI
 BOARD OF WATER COMMISSIONERS
 416 North State Street
 Jackson, Mississippi 39201

CODER

WATER WELL DRILLERS LOG

5-16-79 Griner Drilling Simpson
 date well completed firm name county well located

LANDOWNER:
~~Transcontinental Oil Co.~~
~~1400 First Union Bank Building~~
Shreveport, La.
 (mailing address)

description of formations encountered	from	to
clay & sand streaked	0	108
rock & gravel	108	210
sand & gravel	210	231
clay & sand	231	329
sand & gravel	329	387
	387	450

WELL LOCATION: 1758'S + 1041'E
 No. 4 T 9 R 19 of 1/4
Love Berry Shivers, MS
 miles (distance) of (direction) (nearest town)

WELL PURPOSE: oil field supply
 (home, irrigation, municipal, industrial)

WELL COMPLETION DATA:

(1) diameter (inches) 3"

(2) total depth (feet) 450'

(3) static water level (feet) 110' below above top of ground.

(4) casing steel, 450'
 (material) (depth)
3" if telescope see back.
 (size)

(5) screen 42', 408'
 (length) (depth to top)
3", perforated
 (size) (material)

(6) pump 75
 (HP) (yield gpm)
AC
 (type power)

(7) electric log —
 (yes or no)
 (organization running log)

(8) how well bottom plugged orange peel

CODER

DRILLERS REMARKS:


Miss. Board of Water Commissioners

MAY 29 1979

RECEIVED

If well telescopes please sketch and show depths.

GROUND LEVEL

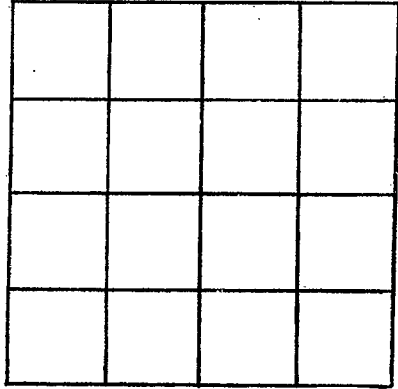

SECTION _____

Please indicate well location X.

ADDITIONAL INFORMATION

A series of horizontal lines for recording additional information.

If more than one screen, show locations of each on sketch.