

SIMPSON  
 \$ 20  
 9-29-79

MISSISSIPPI  
 BOARD OF WATER COMMISSIONERS CODED  
 416 North State Street  
 Jackson, Mississippi 39201

WATER WELL DRILLERS LOG

9-29-79 Griner Drilling SIMPSON  
 date well completed firm name county well located

LANDOWNER:	description of formations encountered	from	to
Marion Corporation P.O. Box 51207 Lafayette, La 70505 (mailing address)	fill dirt gravel gravel chalk sand	0 21 126 294	21 126 294 378
WELL LOCATION: 1320' S + 1320' W sec. 29 T. 10 S. R. 19 E. of Shivers of One/Cor (distance) (direction) (nearest town)			
WELL PURPOSE: (home, irrigation, municipal, industrial)			
WELL COMPLETION DATA:			
(1) diameter (inches) 3 3/4" 3"			
(2) total depth (feet) 378'			
(3) static water level (feet) 130' below top of ground.			
(4) casing steel 378' (material) (depth) 3" if telescope see back. (size)			
(5) screen 42' 336' (length) (depth to top) 3" perforated (size) (material)			
(6) pump — 75 (HP) (yield gpm) AC (type power)			
(7) electric log — (yes or no)  (organization running log)			
(8) how well bottom plugged orange peel			
DRILLERS REMARKS:			

CODED


DEPT. OF NATURAL RESOURCES  
 BUREAU OF LAND & WATER RESOURCES

OCT 26 1979

RECEIVED

If well telescopes please sketch and show depths.

GROUND LEVEL

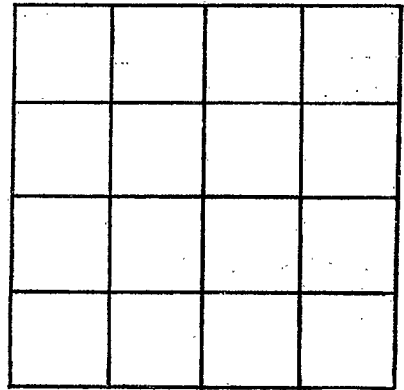

SECTION \_\_\_\_\_

Please indicate well location X.

ADDITIONAL INFORMATION

If more than one screen,  
show locations of each on sketch.