

SIMPSON
 021
 9-1-79

MISSISSIPPI
 BOARD OF WATER COMMISSIONERS CODED
 416 North State Street
 Jackson, Mississippi 39201

WATER WELL DRILLERS LOG

9-1-79 Griner Drilling Simpson
 date well completed firm name county well located

LANDOWNER:	description of formations encountered	from	to
Larco Drilling Company 1700 Capital Towers Jackson, Ms 39205 (mailing address)	Chalk	0	63
	gravel	63	231
	Chalk	231	619
	Chalk + sand	619	630
	streaked sand	630	651
	Chalk	651	693

WELL LOCATION: 1450' N + 1200' E
 sec 21 T 10 N R 19 E of
 Hwy 13 + Hwy 28
 (distance) (direction) (nearest town)

WELL PURPOSE: oil field supply
 (home, irrigation, municipal, industrial)

WELL COMPLETION DATA:

- (1) diameter (inches) 3"
- (2) total depth (feet) 693'
- (3) static water level (feet) 95' below top of ground
- (4) casing Steel 619' (material) (depth)
3" (size) if telescope see back.
- (5) screen 42' 577' (length) (depth to top)
3" perforated (size) (material)
- (6) pump — 50 (HP) (yield gpm)
AC (type power)
- (7) electric log — (yes or no)
(organization running log)

(8) how well bottom plugged orange
 plug

CODED

DEPT. OF NATURAL RESOURCES
 BUREAU OF LAND & WATER RESOURCES


DRILLERS REMARKS:

OCT 26 1979

RECEIVED

If well telescopes please sketch and show depths.

GROUND LEVEL

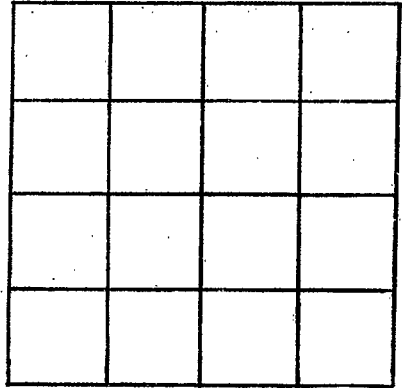

SECTION _____

Please indicate well location X.

ADDITIONAL INFORMATION

If more than one screen,
show locations of each on sketch.