

Simpson
 D-22
 12-20-79

MISSISSIPPI
 BOARD OF WATER COMMISSIONERS
 416 North State Street
 Jackson, Mississippi 39201

CODED

WATER WELL DRILLERS LOG

12-20-79 date well completed
 Griner Drilling firm name
 Simpson county well located

LANDOWNER:

R.E. Williams Drilling
 P.O. Box 698
 Natchez, Ms
 (mailing address)

description of formations encountered

from to

clay, sand	0	208
rock	208	212
clay	212	255
clay	255	355
sand	355	382
clay	382	399

WELL LOCATION: 1200N + 1000W
 sec 21 T 100N R 19 E of
 miles (distance) direction of (nearest town)

B-1
 Smith
 Ashley

WELL PURPOSE: oilfield supply
 (home, irrigation, municipal, industrial)

WELL COMPLETION DATA:

- (1) diameter (inches) 3"
- (2) total depth (feet) 399'
- (3) static water level (feet) 65' below top of ground.
- (4) casing steel 382' (material) (depth)
 3" (size) if telescope see back.
- (5) screen 42' 340' (length) (depth to top)
 3" perforated (size) (material)
- (6) pump - 70 (HP) (yield gpm)
 AC (type power)
- (7) electric log - (yes or no)
 (organization running log)

(8) how well bottom plugged orange peat

DRILLERS REMARKS:


DEPT. OF NATURAL RESOURCES
 BUREAU OF LAND & WATER RESOURCES

JAN 24 1980

RECEIVED

If well telescopes please sketch and show depths.

GROUND LEVEL

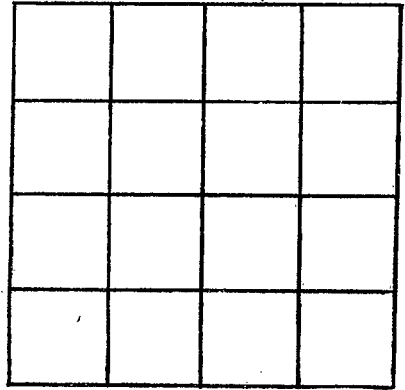

SECTION _____

Please indicate well location X.

ADDITIONAL INFORMATION

If more than one screen, show locations of each on sketch.