

SIMPSON  
 023  
 1-23-80  
 Elog #241

MISSISSIPPI  
 BOARD OF WATER COMMISSIONERS CODED  
 416 North State Street  
 Jackson, Mississippi 39201

WATER WELL DRILLERS LOG

1-23-80 date well completed  
 1980 firm name  
 Simpson county well located

LANDOWNER:  
 Charles Lorey  
 (mailing address)

description of formations encountered	from	to
Sand & Gravel	0	100
CLAY	100	210
Sand	210	240

WELL LOCATION:  
 sec. 6 T. 10 N R. 19 E  
 (distance) miles (direction) of (nearest town)

WELL PURPOSE:  
 (home, irrigation, municipal, industrial)

WELL COMPLETION DATA:  
 (1) diameter (inches) 6"  
 (2) total depth (feet) 90  
 (3) static water level (feet) 100 below top of ground.  
 (4) casing PVC 220 (material) (depth)  
 4 (size) if telescope see back.  
 (5) screen 20 200 (length) (depth to top)  
 4 PVC (size) (material)  
 (6) pump 1/2 20 (HP) (yield gpm)  
 (type power)

(7) electric log (yes or no)  
 (organization running log)  
 (8) how well bottom plugged Best


DRILLERS REMARKS:

DEPT. OF NATURAL RESOURCES  
 BUREAU OF LAND & WATER RESOURCES  
 MAY 28 1980  
 RECEIVED

If well telescopes please sketch and show depths.

✓

GROUND LEVEL

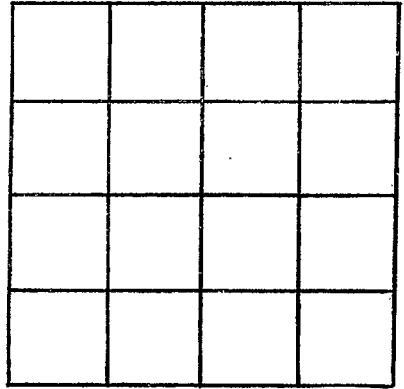

SECTION \_\_\_\_\_

Please indicate well location X.

ADDITIONAL INFORMATION

If more than one screen,  
show locations of each on sketch.