

Simpson
 024
 4-1-80
 Elog # 246

MISSISSIPPI
 BOARD OF WATER COMMISSIONERS **CODED**
 416 North State Street
 Jackson, Mississippi 39201

WATER WELL DRILLERS LOG

4-1-80 19 Gain water well for Simpson
 date well completed firm name county well located

LANDOWNER:
Bud Brooks
 (mailing address)

description of formations encountered	from	to
CLAY	0	20
SAND	20	60
	60	140

WELL LOCATION:
 sec. 4 T. 10 N R. 4 E
 (distance) miles (direction) of (nearest town)

CODED

WELL PURPOSE:
 (home, irrigation, municipal, industrial)

- WELL COMPLETION DATA:
- (1) diameter (inches) 4"
 - (2) total depth (feet) 140
 - (3) static water level (feet) 90 below/above top of ground.
 - (4) casing PVC, 120 (material), (depth)
 - 4 (size) if telescope see back.
 - (5) screen 90, 120 (length), (depth to top)
 - 4 (size), PVC (material)
 - (6) pump 3/4 (HP), 12 (yield gpm)
 - (type power)
 - (7) electric log yes or no
MOS (organization running log)
 - (8) how well bottom plugged BWV

DEPT. OF NATURAL RESOURCES
 BUREAU OF LAND & WATER RESOURCES


MAY 28 1980

RECEIVED

DRILLERS REMARKS:

If well telescopes please sketch and show depths.

GROUND LEVEL

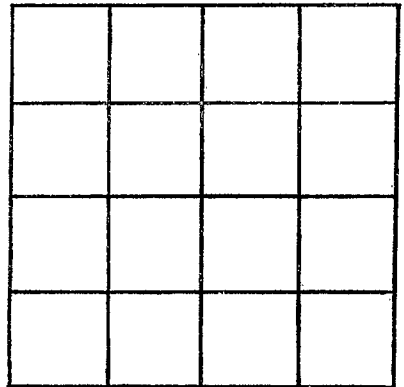

SECTION _____

Please indicate well location X.

ADDITIONAL INFORMATION

If more than one screen,
show locations of each on sketch.