

SIMPSON  
 025  
 4-28-80  
 Elev # 248

MISSISSIPPI  
 BOARD OF WATER COMMISSIONERS  
 416 North State Street  
 Jackson, Mississippi 39201

WATER WELL DRILLERS LOG

CODED

4-28 1980 date well completed  
 Simpson firm name  
 Simpson county well located

LANDOWNER:  
 Steve Kelly  
 (mailing address)

description of formations encountered	from	to
Sand & Gravel	142	142
CLAY	240	242
Sand	242	252

WELL LOCATION:  
 sec. 8 T 14 N R 14 E W  
 (distance) miles (direction) of (nearest town)

WELL PURPOSE:  
 (home, irrigation, municipal, industrial)

CODED

- WELL COMPLETION DATA:
- (1) diameter (inches) 4 1/2
  - (2) total depth (feet) 252
  - (3) static water level (feet) 140 below top of ground
  - (4) casing POC 242 (material) (depth)
  - 1/2 (size) if telescope see back.
  - (5) screen 10 242 (length) (depth to top)
  - 4 POC (size) (material)
  - (6) pump 1 10 (HP) (yield gpm)
  - (type power)
  - (7) electric log (yes or no) MGS (organization running log)
  - (8) how well bottom plugged BWW

DRILLERS REMARKS:


DEPT. OF NATURAL RESOURCES  
 BUREAU OF LAND & WATER RESOURCES

MAY 28 1980

RECEIVED

If well telescopes please sketch and show depths.

GROUND LEVEL

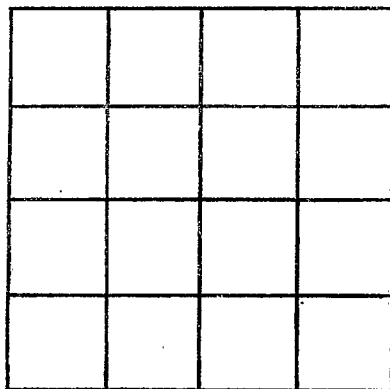

SECTION \_\_\_\_\_

Please indicate well location X.

ADDITIONAL INFORMATION

If more than one screen,  
show locations of each on sketch.