

Simpson  
 # 26  
 5-20-80

MISSISSIPPI  
 BOARD OF WATER COMMISSIONERS  
 416 North State Street  
 Jackson, Mississippi 39201

WATER WELL DRILLERS LOG

CODED

5-2580 Griner Drilling Simpson  
 date well completed # 2 Water Well firm name county well located

LANDOWNER:  
 Transcontinental Oil Corp  
 1400 First Natl. Bank Bldg  
 Shreveport, La  
 (mailing address)

description of formations encountered	from	to
chalk + sand	0	21
sand + gravel	21	252
chalk	252	315
sand	315	420
streaked chalk	420	640

WELL LOCATION: 1200' S + 1200' E  
 No 1 road 26 T. 10 R. 19 E of  
 26-4 Shiver, Shreveport, La  
 (distance) miles (direction) of (nearest town)

WELL PURPOSE: oil field supply  
 (home, irrigation, municipal, industrial)

- WELL COMPLETION DATA:
- (1) diameter (inches) 3"
  - (2) total depth (feet) 640'
  - (3) static water level (feet) 200' <sup>below</sup> top of ground
  - (4) casing steel 420' (material) (depth)  
 3" (size) if telescope see back.
  - (5) screen 42' 378' (length) (depth to top)  
 3" perforated (size) (material)
  - (6) pump — 40 (HP) (yield gpm)  
 AC (type power)
  - (7) electric log — (yes or no)  
 (organization running log)
  - (8) how well bottom plugged peel orange

DRILLERS REMARKS:

DEPT. OF NATURAL RESOURCES  
 BUREAU OF LAND & WATER RESOURCES


MAY 29 1980

RECEIVED

If well telescopes please sketch and show depths.

---

GROUND LEVEL

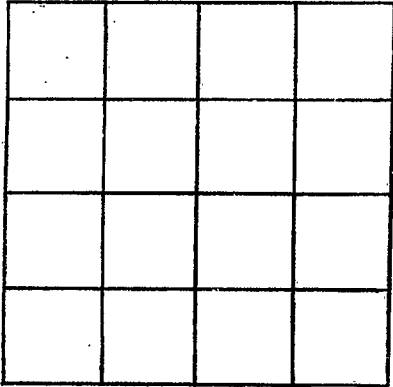

SECTION \_\_\_\_\_

Please indicate well location X.

ADDITIONAL INFORMATION

A series of 20 horizontal lines for entering information, starting below the 'ADDITIONAL INFORMATION' header. A small vertical mark is present on the fifth line from the top of this section.

If more than one screen,  
show locations of each on sketch.