

Simpson
 Ø 27
 5-23-80

MISSISSIPPI
 BOARD OF WATER COMMISSIONERS
 416 North State Street
 Jackson, Mississippi 39201

CODED

WATER WELL DRILLERS LOG

5-23-80 Griner Drilling Simpson
 date well completed firm name county well located

LANDOWNER: Water Well
 Transcontinental Oil Corp
 1400 First Natl. Bank Bldg
 Shreveport, La.
 (mailing address)

description of formations encountered	from	to
sand	0	21
sand & gravel	21	252
chalk	252	315
sand	315	382
chalk	382	399

WELL LOCATION: 1200' S 1300' E
 Sec. 26 T 10 N R 19 E of NW/4
 26-4 Shivers
 (distance) (direction) (nearest town)

WELL PURPOSE: oil field supply
 (home, irrigation, municipal, industrial)

WELL COMPLETION DATA:

(1) diameter (inches) 3"

(2) total depth (feet) 399'

(3) static water level (feet) 200' ^{below} _{above} top of ground.

(4) casing steel 378'
 (material) (depth)

3" If telescope see back.
 (size)

(5) screen 42' 336'
 (length) (depth to top)

3" perforated
 (size) (material)

(6) pump — 40
 (HP) (yield gpm)

AC
 (type power)

(7) electric log —
 (yes or no)

(organization running log)

CODED

DEPT. OF NATURAL RESOURCES
 BUREAU OF LAND & WATER RESOURCES

MAY 29 1980


RECEIVED

(8) how well bottom plugged orange
peel

DRILLERS REMARKS:

If well telescopes please sketch and show depths.

GROUND LEVEL

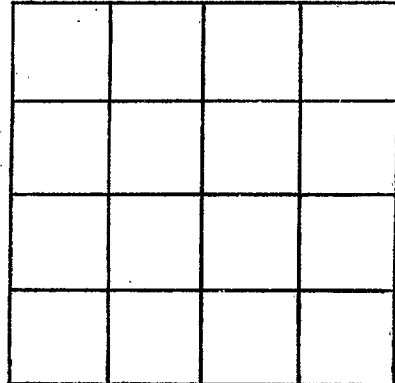

SECTION _____

Please indicate well location X.

ADDITIONAL INFORMATION

A series of horizontal lines for providing additional information.

If more than one screen, show locations of each on sketch.