

SIMPSON
 29
 5-30-80

MISSISSIPPI
 BOARD OF WATER COMMISSIONERS
 416 North State Street
 Jackson, Mississippi 39201

CODED

WATER WELL DRILLERS LOG

5-30 1980 *Gunn Walker Simpson*
 date well completed firm name county well located

LANDOWNER:
Norman McCoy
 NORMAN MCCOY
 (mailing address)

description of formations encountered
Sand & gravel from 0 to 220

WELL LOCATION:
 sec. 4 T 7 N R 19 E W
 (distance) miles (direction) of (nearest town)

CODED

WELL PURPOSE:
 (home, irrigation, municipal, industrial)


- WELL COMPLETION DATA:
- (1) diameter (inches) *4"*
 - (2) total depth (feet) *220*
 - (3) static water level (feet) *168* below top of ground.
 - (4) casing *Pvc*, *220*,
 (material) (depth)
4"
 (size) if telescope see back.
 - (5) screen *20*, *200*
 (length) (depth to top)
LP, *Pvc*
 (size) (material)
 - (6) pump *1/2*, *20*
 (HP) (yield gpm)
 (type power)
 - (7) electric log (yes or no) *MS*
 (organization running log)
 - (8) how well bottom plugged *Bad*

DRILLERS REMARKS:

DEPT. OF NATURAL RESOURCES
 BUREAU OF LAND & WATER RESOURCES
 NOV 12 1980
 RECEIVED

If well telescopes please sketch and show depths.

GROUND LEVEL

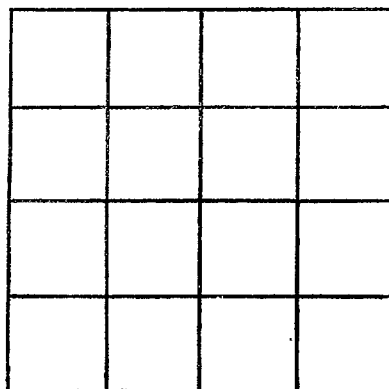

SECTION _____

Please indicate well location X.

ADDITIONAL INFORMATION

If more than one screen,
show locations of each on sketch.