

MISSISSIPPI DEPARTMENT OF NATURAL RESOURCES

Bureau of Land and Water Resources

Southport Mall

P.O. Box 10631

Jackson, Mississippi 39205

CODED

WATER WELL DRILLERS LOG

SIMPSON
Q 30
12-4-80

Greiner Drilling Service Simpson

12-4-80 date well completed

firm name

county well located

LANDOWNER:	description of formations encountered	from	to
Transcontinental Oil 8400 East National Park Shreveport, La. 71101 (mailing address)	top fill clay	0	84
	clay	84	294
	clay	294	357
	streaked	357	385
	sand	385	418
	clay	418	420

WELL LOCATION: 1200'S & 1200'E
No. 35 15 N R 19 E of
Meekins Oak Grove
et al. miles (direction) (nearest town)
35 15 N

WELL PURPOSE: oil field
(home, irrigation, municipal, industrial)

WELL COMPLETION DATA:

- (1) diameter (inches) 3"
- (2) total depth (feet) 420'
- (3) static water level (feet) 150' below top of ground.
- (4) casing steel, 420' (material) (depth)
3" (size) if telescope see back.
- (5) screen 42' 378' (length) (depth to top)
4" perforated (size) (material)
- (6) pump 45 (HP) (yield gpm)
ac (type power)
- (7) electric log (yes or no)

(organization running log)

(8) how well bottom plugged orange
peel

DRILLERS REMARKS:


DEPT. OF NATURAL RESOURCES
BUREAU OF LAND & WATER RESOURCES

JAN 19 1981

RECEIVED

If well telescopes please
sketch and show depths.

GROUND LEVEL

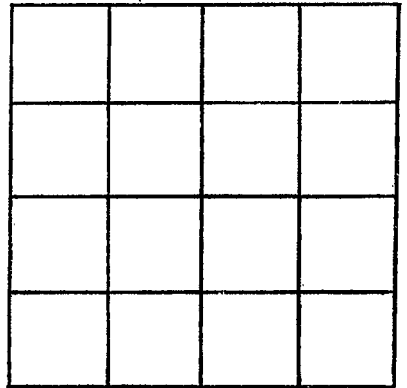

SECTION _____

Please indicate well location X.

ADDITIONAL INFORMATION

If more than one screen,
show locations of each on sketch.