

MISSISSIPPI DEPARTMENT OF NATURAL RESOURCES

Bureau of Land and Water Resources

Southport Mall

P.O. Box 10631

Jackson, Mississippi 39209

WATER WELL DRILLERS LOG

CODED

Griner Drilling Service, Inc.

SIMPSON

SIMPSON  
031  
3-2-81

date well completed

firm name

county well located

LANDOWNER:

Marion Corporation  
P.O. Box 3027  
Daphne, Alabama

description of formations encountered

from

to

sand + gravel

0 145

clay

145 168

WELL LOCATION:

1500'S-1700'W  
Sec 25 T 50N R 17E of  
Shiver 1200 S  
1200 W of NE corner  
(distance) (direction) (nearest town)

Sec 32 10N 19W

WELL PURPOSE:

oil field supply

1200'S  
1200'W of NE CORNER

WELL COMPLETION DATA

- (1) diameter (inches) 4"
- (2) total depth (feet) 168'
- (3) static water level (feet) 25' (below above top of ground.)
- (4) casing steel, 147' (material) (depth)  
4" if telescope see back. (size)
- (5) screen 42', 105' (length) (depth to top)  
4", perforated (size) (material)
- (6) pump —, 70 (HP) (yield gpm)  
AC (type power)
- (7) electric log — (yes or no)

(organization running log)

- (8) how well bottom plugged Orange peel

DRILLERS REMARKS:


DEPT. OF NATURAL RESOURCES  
BUREAU OF LAND & WATER RESOURCES

MAR 31 1981

RECEIVED

If well telescopes please sketch and show depths.

GROUND LEVEL

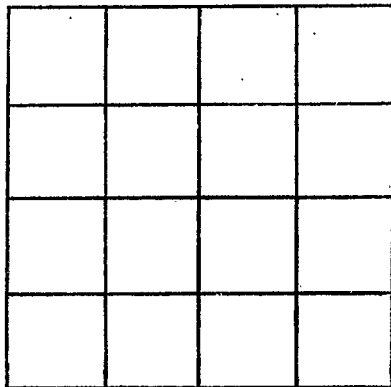

SECTION \_\_\_\_\_

Please indicate well location X.

ADDITIONAL INFORMATION

If more than one screen,  
show locations of each on sketch.