

MISSISSIPPI DEPARTMENT OF NATURAL RESOURCES

Bureau of Land and Water Resources

Southport Mall

P.O. Box 10631

Jackson, Mississippi 39209

WATER WELL DRILLERS LOG

CODED.

Simpson
Q 32
6-26-81

6-26-81 date well completed Simpson Drilling Service, Inc firm name Simpson county well located

LANDOWNER:
Callons Petroleum
P.O. Box 1287
Natchez, Ms. 39120
 (mailing address)

description of formations encountered	from	to
<u>sand pea gravel</u>	<u>0</u>	<u>189</u>

WELL LOCATION: 1500'St 442'W of
3 T 9 N R 19 E
ONE/4
Barry Oak Grove Field
 (distance) (direction) (nearest town)

WELL PURPOSE: oil field
gas well supply
 (home, irrigation, municipal, industrial)

WELL COMPLETION DATA:

(1) diameter (inches) 3"

(2) total depth (feet) 189'

(3) static water level (feet) 25' below top of ground.

(4) casing Steel 189'
 (material) (depth)

3"
 (size) if telescope see back.

(5) screen 42' 147'
 (length) (depth to top)

3" perforated
 (size) (material)

(6) pump — 80
 (HP) (yield gpm)


ac
 (type power)

(7) electric log —
 (yes or no)

—
 (organization running log)

(8) how well bottom plugged range


CODED

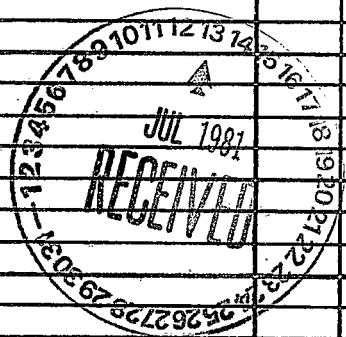

DRILLERS REMARKS:
peel

If well telescopes please sketch and show depths.

GROUND LEVEL

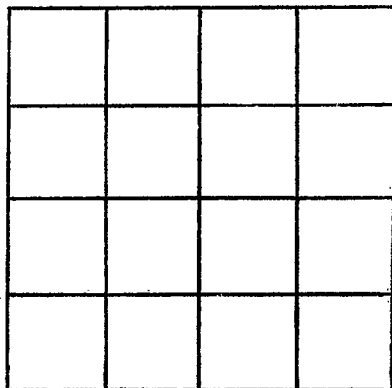

SECTION _____

Please indicate well location X.

ADDITIONAL INFORMATION

If more than one screen,
show locations of each on sketch.