

MISSISSIPPI DEPARTMENT OF NATURAL RESOURCES

Bureau of Land and Water Resources

Southport Mall

P.O. Box 10631

Jackson, Mississippi 39209

WATER WELL DRILLERS LOG

CODED

SIMPSON
φ 33
8-17-81

8-17-81 *Spencer Drilling Service Inc* Simpson
 date well completed firm name county well located

LANDOWNER:	description of formations encountered	from	to
<i>Callons Petroleum</i> <i>P.O. Box 1287</i> <i>Natchez, MS 39120</i> (mailing address)	<i>sand, clay</i>	<i>0</i>	<i>56</i>
WELL LOCATION: <i>1420' S + 1980' E</i> <i>#1 sec. 34 T 10 N R 19 E of</i> <i>Dun Oak Grove NW 10</i> (distance) (nearest town)	<i>sand, gravel</i>	<i>56</i>	<i>119</i>
WELL PURPOSE: <i>oil field</i> (home, irrigation, municipal, industrial, supply)	<i>sand, gravel</i>	<i>119</i>	<i>203</i>
WELL COMPLETION DATA:	<i>clay, sand</i>	<i>203</i>	<i>245</i>
(1) diameter (inches) <i>3"</i>	<i>clay</i>	<i>245</i>	<i>308</i>
(2) total depth (feet) <i>392'</i>	<i>sand</i>	<i>308</i>	<i>392</i>
(3) static water level (feet) <i>100' below</i> top of ground.			
(4) casing <i>steel 378'</i> (material) (depth)			
<i>3"</i> (size) if telescope see back.			
(5) screen <i>42' 336'</i> (length) (depth to top)			
<i>3"</i> (size) <i>perforated</i> (material)			
(6) pump <i>70</i> (HP) (yfeild gpm)			
<i>ac</i> (type power)			
(7) electric log <i>—</i> (yes or no)			
(organization running log)			
(8) how well bottom plugged <i>orange</i>			
<i>peel</i>			
DRILLERS REMARKS:			


CODED

DEPT. OF NATURAL RESOURCES
BUREAU OF LAND & WATER RESOURCES

SEP - 8 1981
RECEIVED

If well telescopes please sketch and show depths.

GROUND LEVEL

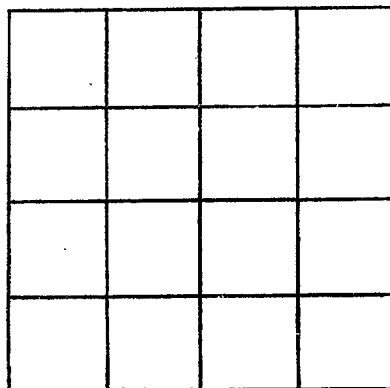

SECTION _____

Please indicate well location X.

ADDITIONAL INFORMATION

If more than one screen,
show locations of each on sketch.