

MISSISSIPPI DEPARTMENT OF NATURAL RESOURCES

Bureau of Land and Water Resources

Southport Mall

P.O. Box 10631

Jackson, Mississippi 39209

CODED

WATER WELL DRILLERS LOG

Griner Drilling Service, Inc.

SIMPSON

SIMPSON
034
12/14/81

12-14-81
date well completed

Griner Drilling Service, Inc.
firm name

SIMPSON
county well located

LANDOWNER:

Callons Petroleum Company

P.O. Box 1287

Natchez, MS 39120

(mailing address)

WELL LOCATION:

1401 S. 17th St

sec. *4* T. *9* N.

R. *19* NW/4

(W)

description of formations encountered

from

to

sand, clay

0 21

sand, gravel

21 84

clay, sand

84 126

sand, gravel

126 189

1401 S. 17th St

sec. *4* T. *9* N. R. *19* NW/4

(W)

No. 1 Shivers
Love Berry Oak Grove Field
distance miles (approx.) of (approx. down)

WELL PURPOSE: *oil field supply*
(home, irrigation, municipal, industrial)

WELL COMPLETION DATA:

- (1) diameter (inches) *4"*
- (2) total depth (feet) *189'*
- (3) static water level (feet) *60'* *(below)* above top of ground.

- (4) casing *steel 189'*
(material) (depth)
4"
(size) if telescope see back.

- (5) screen *42'* *147'*
(length) (depth to top)
4" *perforated*
(size) (material)

- (6) pump *-* *70*
(HP) (yield gpm)
AC
(type power)

- (7) electric log *NO -*
(yes or no)

(organization running log)

- (8) how well bottom plugged *orange peel*

DRILLERS REMARKS:

CODED


DEPT. OF NATURAL RESOURCES
BUREAU OF LAND & WATER RESOURCES

JAN 15 1982

RECEIVED

If well telescopes please sketch and show depths.

GROUND LEVEL

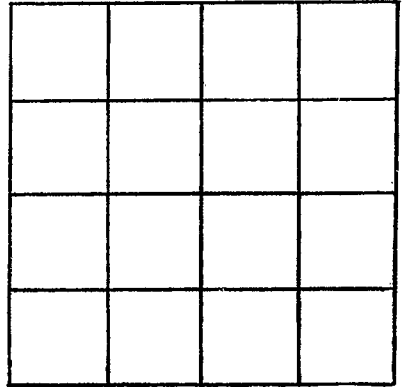

SECTION _____

Please indicate well location X.

ADDITIONAL INFORMATION

If more than one screen,
show locations of each on sketch.