

MISSISSIPPI DEPARTMENT OF NATURAL RESOURCES

Bureau of Land and Water Resources

Southport Mall

P.O. Box 10631

Jackson, Mississippi 39209

CODED

WATER WELL DRILLERS LOG

Griner Drilling Service, Inc.

Simpson

SIMPSON
Ø 35
1-10-82

date well completed

firm name

county well located

LANDOWNER:
*Transcontinental Oil Corp.
1700 Capital Towers
Jackson, Ms. 39205*

description of formations encountered

from

to

sand, gravel

0

294

(mailing address)

WELL LOCATION: *1465'S & 1200'E*

No. 1 sec. 36 T. 10 R. 19 E NW/4
604 Berry 36-5 S Oak Grove Field
(distance) miles (direction) of (nearest town)

WELL PURPOSE: *oil field*
(home, irrigation, municipal, industrial)

WELL COMPLETION DATA:

- (1) diameter (inches) *3"*
- (2) total depth (feet) *294'*
- (3) static water level (feet) *60'* ^{below} top of ground.
- (4) casing *steel* *294'*
(material) (depth)
3"
(size) if telescope see back.
- (5) screen *42'* *252'*
(length) (depth to top)
3" *perforated*
(size) (material)
- (6) pump *—* *70*
(HP) (yield gpm)
AC
(type power)
- (7) electric log *—*
(yes or no)

CODED

(organization running log)

(8) how well bottom plugged *orange peel*

DRILLERS REMARKS:


DEPT. OF NATURAL RESOURCES
BUREAU OF LAND & WATER RESOURCES

JAN 21 1982

RECEIVED

If well telescopes please sketch and show depths.

GROUND LEVEL

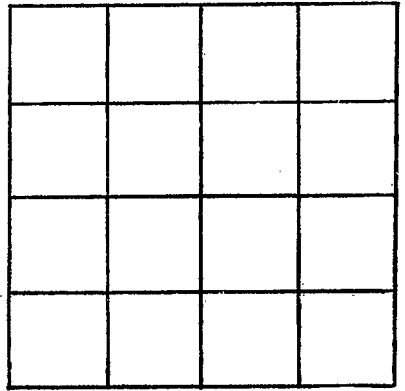

SECTION _____

Please indicate well location X.

ADDITIONAL INFORMATION

If more than one screen,
show locations of each on sketch.