

MISSISSIPPI DEPARTMENT OF NATURAL RESOURCES

Bureau of Land and Water Resources

Southport Mall

P.O. Box 10631

Jackson, Mississippi 39209

WATER WELL DRILLERS LOG

CODED

SIMPSON  
Q 36  
6/4/83

6-4-83

Griner Drilling Service, Inc.

SIMPSON

date well completed

firm name

county well located

LANDOWNER:

Transcontinental Oil Corp.  
1706 Capital Towers  
Jackson, Ms. 39201  
(mailing address)

description of formations encountered

from

to

SAND - pea gravel 0 189

clay 189 231

SAND 231 280

clay 280 300

WELL LOCATION: 1900 N 4 100' W

sec 2 T 9 N R 19 SE 10W

Paulsone Oak Grove Field  
miles (direction) (nearest town)

WELL PURPOSE: oil field supply  
(home, irrigation, municipal, industrial)

WELL COMPLETION DATA:

- (1) diameter (inches) 3"
- (2) total depth (feet) 300'
- (3) static water level (feet) 70' below top of ground.
- (4) casing Steel 280' (material) (depth)  
3" If telescope see back. (size)
- (5) screen 42' 238' (length) (depth to top)  
3" perforated (size) (material)
- (6) pump (HP) 70 (yield gpm)  
AC (type power)
- (7) electric log (yes or no)

CODED

DEPT. OF NATURAL RESOURCES  
BUREAU OF LAND & WATER RESOURCES

JUN 22 1983


RECEIVED

(organization running log)  
(8) how well bottom plugged orange peel

DRILLERS REMARKS:

If well telescopes please sketch and show depths.

GROUND LEVEL

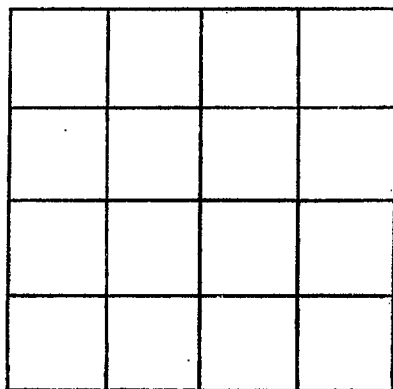

SECTION \_\_\_\_\_

Please indicate well location X.

ADDITIONAL INFORMATION

If more than one screen, show locations of each on sketch.