

MISSISSIPPI DEPARTMENT OF NATURAL RESOURCES

Bureau of Land and Water Resources

Southport Mall

P.O. Box 10631

Jackson, Mississippi 39209

CODED

WATER WELL DRILLERS LOG

Griner Drilling Service, Inc.

SIMPSON

SIMPSON
Q 37
6/26/83

date well completed

firm name

county well located

LANDOWNER:
Transcontinental Oil
1700 Capital Towers
Jackson, Ms. 39201
(mailing address)

description of formations encountered

from

to

SAND

0

90

Stratified

90

145

SAND, deep gravel

145

235

WELL LOCATION: *1200' S + 600' E*

sec *34* T *10N* R *19 E NW/40*

No. 1 Walker
W. 5/8 mile of *Oak Grove Field*
(distance) (direction) (nearest town)

WELL PURPOSE: *oil field supply*
(home, irrigation, municipal, industrial)

WELL COMPLETION DATA:

(1) diameter (inches) *3"*

(2) total depth (feet) *235'*

(3) static water level (feet) *70'* *below* *above*
top of ground.

(4) casing *steel*, *231'*
(material) (depth)

3"
(size) if telescope see back.

(5) screen *42'*, *189'*
(length) (depth to top)

3" *perforated*
(size) (material)

(6) pump *75*
(HP) (yield gpm)

HC
(type power)

(7) electric log *—*
(yes or no)

—
(organization running log)

(8) how well bottom plugged *Orange*
peel

DRILLERS REMARKS:

CODED


DEPT. OF NATURAL RESOURCES
BUREAU OF LAND & WATER RESOURCES

AUG 4 1983

RECEIVED

If well telescopes please
sketch and show depths.

GROUND LEVEL

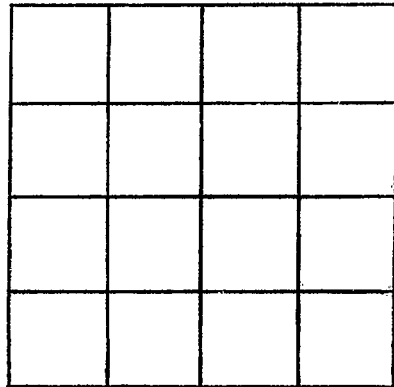

SECTION _____

Please indicate well location X.

ADDITIONAL INFORMATION

If more than one screen,
show locations of each on sketch.