

MISSISSIPPI DEPARTMENT OF NATURAL RESOURCES

Bureau of Land and Water Resources

Southport Mall

P.O. Box 10631

Jackson, Mississippi 39209 **CODED**

WATER WELL DRILLERS LOG

*Griner Drilling Service, Inc.*

*Simpson*

① 38  
Simpson Co.  
11-20-83

11-20-83  
date well completed

firm name

county well located

LANDOWNER:	description of formations encountered	from	to
<i>Callon Petroleum</i> <i>P.O. Box 1287</i> <i>Natchez, Ms. 39120</i> (mailing address)	<i>streaked sand &amp; clay</i>	<i>0</i>	<i>84</i>
WELL LOCATION: <i>1200' N x 200' E</i> <i>sq. 27 T 10 N R 19 E SW/40</i> <i>No. 1 George</i> miles <i>Oak Grove</i> Field <i>MS</i> (distance) (direction) (nearest town)	<i>sand gravel</i>	<i>84</i>	<i>252</i>
WELL PURPOSE: <i>oil field supply</i> (home, irrigation, municipal, industrial)			
WELL COMPLETION DATA:			
(1) diameter (inches) <i>4"</i>			
(2) total depth (feet) <i>252'</i>			
(3) static water level (feet) <i>80'</i> <input checked="" type="checkbox"/> below <input type="checkbox"/> above top of ground.			
(4) casing <i>steel</i> , <i>252'</i> (material) (depth) <i>4"</i> (size) If telescope see back.			
(5) screen <i>42'</i> , <i>210'</i> (length) (depth to top) <i>4"</i> , <i>perforated</i> (size) (material)			
(6) pump <i>—</i> , <i>80</i> (HP) (yield gpm) <i>AC</i> (type power)			
(7) electric log <i>—</i> (yes or no) <i>—</i> (organization running log)			
(8) how well bottom plugged <i>orange peel</i>			
DRILLERS REMARKS:			

**LOGGED**


DEPT. OF NATURAL RESOURCES  
BUREAU OF LAND & WATER RESOURCES

NOV 29 1983

**RECEIVED**

If well telescopes please sketch and show depths.

GROUND LEVEL

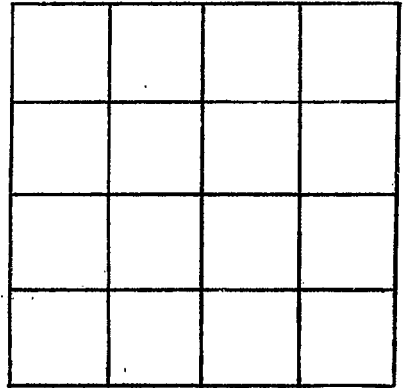

SECTION \_\_\_\_\_

Please indicate well location X.

ADDITIONAL INFORMATION

If more than one screen,  
show locations of each on sketch.