

MISSISSIPPI DEPARTMENT OF NATURAL RESOURCES

Bureau of Land and Water Resources

Southport Mall

P.O. Box 10631

Jackson, Mississippi 39209

WATER WELL DRILLERS LOG

CODED

Simpson
 39
 4/15/84
 4-15-84

Griner Drilling
 Service, Inc.

Simpson

date well completed

firm name

county well located

LANDOWNER:

Marion Drilling
 P.O. Box 3027
 Daphne, Ala. 32565
 (mailing address)

description of formations encountered

from

to

gravel	126	126
clay, gravel	126	290
sand, pea gravel	290	336

WELL LOCATION: 1850'N + 1431'E

sec. 28 T. 10 N. R. 19 E. SW/4

No. 1 Roscoe Oak Grove Field
 1/2 miles (distance) N (direction) of (nearest town)
 Berles

WELL PURPOSE: oilfield supply
 28-11 (home, irrigation, municipal, industrial)

WELL COMPLETION DATA:

- (1) diameter (inches) 3"
- (2) total depth (feet) 336'
- (3) static water level (feet) 70' below top of ground.
- (4) casing Steel 336' (material) (depth)
 3" (size) if telescope see back.
- (5) screen 42' 294' (length) (depth to top)
 3" perforated (size) (material)
- (6) pump 90 (HP) (yield gpm)
 AC (type power)
- (7) electric log (yes or no)

(organization running log)

- (8) how well bottom plugged orange peel

DRILLERS REMARKS:


DEPT. OF NATURAL RESOURCES
 BUREAU OF LAND & WATER RESOURCES

MAY -7 1984

RECEIVED

If well telescopes please
sketch and show depths.

GROUND LEVEL

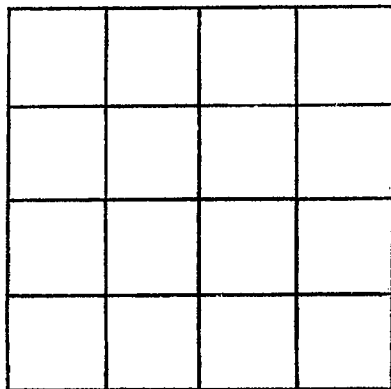

SECTION _____

Please indicate well location X.

ADDITIONAL INFORMATION

If more than one screen,
show locations of each on sketch.