

MISSISSIPPI DEPARTMENT OF NATURAL RESOURCES

Bureau of Land and Water Resources

Southport Mall

P.O. Box 10631

Jackson, Mississippi 39209

CODED

WATER WELL DRILLERS LOG

Griner Drilling Service, Inc.

Simpson

<i>SIMPSON</i>
<i>Q 40</i>

date well completed

firm name

county well located

10-2-84

LANDOWNER:
Marion Drilling
P.O. Box 3027
Daphne, Alabama.
(mailing address)

description of formations encountered	from	to
<i>clay</i>	<i>0</i>	<i>10</i>
<i>sand, pea gravel</i>	<i>10</i>	<i>105</i>
<i>chalk</i>	<i>105</i>	<i>147</i>
<i>sand, pea gravel</i>	<i>147</i>	<i>210</i>
<i>chalk</i>	<i>210</i>	<i>294</i>
<i>sand</i>	<i>294</i>	<i>362</i>

WELL LOCATION: *330' N & 330' E*
 sec. *26* T. *10* N. R. *19* E. SW 1/4
No. 2 *Water* *Oak Grove, Field*
 (distance) (direction) (nearest town)

WELL PURPOSE: *oilfield supply*
 (home, irrigation, municipal, industrial)

WELL COMPLETION DATA:

- (1) diameter (inches) *3"*
- (2) total depth (feet) *362'*
- (3) static water level (feet) *145'* below above top of ground.
- (4) casing *steel* *362'*
 (material) (depth)
- 3"*
 (size) if telescope see back.
- (5) screen *42'* *320'*
 (length) (depth to top)
- 3"* *perforated*
 (size) (material)
- (6) pump *—* *70*
 (HP) (yield gpm)
- AC*
 (type power)
- (7) electric log yes no
 (organization running log)
- (8) how well bottom plugged *orange*
peel

DEPT. OF NATURAL RESOURCES
 BUREAU OF LAND & WATER RESOURCES


OCT 22 1984

RECEIVED

DRILLERS REMARKS:

If well telescopes please
sketch and show depths.

GROUND LEVEL

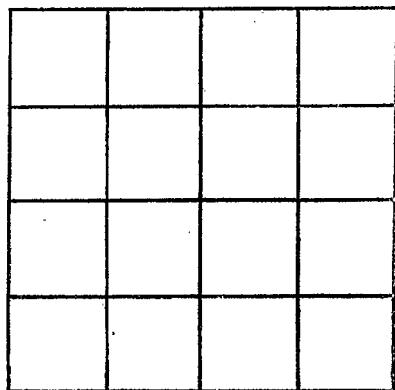

SECTION _____

Please indicate well location X.

ADDITIONAL INFORMATION

If more than one screen,
show locations of each on sketch.