

042
Simpson
8-4-85

MISSISSIPPI
BOARD OF WATER COMMISSIONERS
416 North State Street
Jackson, Mississippi 39201

CODED

WATER WELL DRILLERS LOG

Griner Drilling
Service, INC.

SIMPSON

8-4-85 date well completed

Griner Drilling Service, INC. firm name

SIMPSON county well located

LANDOWNER:	description of formations encountered	from	to
Exeter Drilling 144 Elk Place Suite 1502 New Orleans, LA 70112	SAND, gravel	0	231
WELL LOCATION: 1200' 54" 2400' 15" sec. 2 T 9 (N) R 19 E No. 2 Virgil Oak Grove Field Berry (distance) (direction) (nearest town)			
WELL PURPOSE: oilfield supply (home, irrigation, municipal, industrial)			
WELL COMPLETION DATA:			
(1) diameter (inches) 3"			
(2) total depth (feet) 231'			
(3) static water level (feet) 30' below top of ground.			
(4) casing steel, 231' (material) (depth) 3" (size) If telescope see back.			
(5) screen 42' 189' (length) (depth to top) 3" perforated (size) (material)			
(6) pump - 90 (HP) (yield gpm) AC (type power)			
(7) electric log (yes or no) (organization running log)			
(8) how well bottom plugged orange peel			
DRILLERS REMARKS:			


CODED

RECEIVED
SEP 28 1985

Department of Natural Resources
Bureau of Land & Water

If well telescopes please sketch and show depths.

GROUND LEVEL

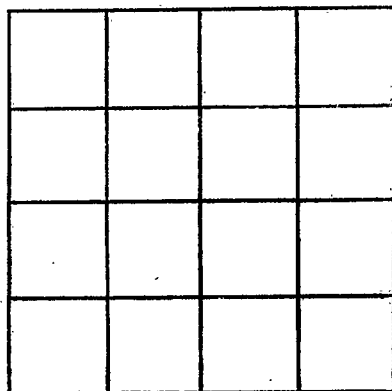

SECTION _____

Please indicate well location X.

ADDITIONAL INFORMATION

If more than one screen, show locations of each on sketch.