

MISSISSIPPI DEPARTMENT OF NATURAL RESOURCES

Bureau of Land and Water Resources

Southport Mall

P.O. Box 10631

Jackson, Mississippi 39209

WATER WELL DRILLERS LOG

Griner Drilling Service, Inc. SIMPSON

Simpson
Φ 43

CODED

date well completed

firm name

county well located

11-5-85

LANDOWNER:

description of formations encountered

from

to

Exeter Drilling

144 Elk Place

Suite 1502

SAND + GRAVEL

0

147

New Orleans, La 70112

CLAY + ROCKS

147

194

WELL LOCATION: *1980 S + 2020 W*

sec. *17 T-10 N* R. *19 E* of

SAND + GRAVEL

194

290

SUCCO, INC.

*No. 1 D.L. miles *Dak Grove**

CLAY

290

294

Brown et al

WELL PURPOSE: *oilfield supply*
 (home, irrigation, municipal, industrial)

WELL COMPLETION DATA:

(1) diameter (inches) *3"*

(2) total depth (feet) *294'*

(3) static water level (feet) *75'* ^{Below} _{above} top of ground.

(4) casing *steel* *294'*
 (material) (depth)

CODED

3"
 (size) if telescope see back.

(5) screen *42'* *252'*
 (length) (depth to top)

3" *perforated*
 (size) (material)

(6) pump *—* *70-75*
 (HP) (yield gpm)

AC
 (type power)

(7) electric log *—*
 (yes or no)

(organization running log)

(8) how well bottom plugged *orange*
peel


DRILLERS REMARKS:



Department of Natural Resources
 Bureau of Land & Water

If well telescopes please
sketch and show depths.

GROUND LEVEL

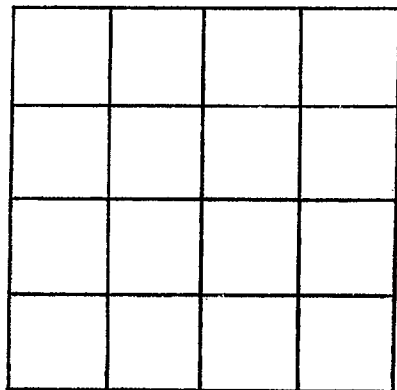

SECTION _____

Please indicate well location X.

ADDITIONAL INFORMATION

If more than one screen,
show locations of each on sketch.