

MISSISSIPPI DEPARTMENT OF NATURAL RESOURCES

Bureau of Land and Water Resources

Southport Mall

P.O. Box 10631

Jackson, Mississippi 39209

WATER WELL DRILLERS LOG

Simpson
 \$ 45

Griner Drilling Service, Inc.

SIMPSON

1-21-87
 date well completed

firm name

county well located

LANDOWNER:

Murco Drilling Corp.
1908 Beck Bldg.
Shreveport, La. 71101
 (mailing address)

description of formations encountered

from

to

Fill

0 6

streaked

6 35

WELL LOCATION: 1200 S + 1437 W

sec. 27 10 (N) R. 19 of

sand, pea gravel 35 185

Ka-Lyn Oil Co. Oak Grove Field
 (distance) (direction) (nearest town)
No. 1 C.L. Griffith 27-2

clay, rock 185 240

WELL PURPOSE: oil field rig supply
 (home, irrigation, municipal, industrial)

WELL COMPLETION DATA:

(1) diameter (inches) 4"

(2) total depth (feet) 240'

(3) static water level (feet) 50' below
 top of ground.

(4) casing 189' of 4" steel
 (material) (depth)
4"
 (size) If telescope see back.

(5) screen 20' 169'
 (length) (depth to top)
4" stainless
 (size) (material)

(6) pump 7 1/2 100
 (HP) (yield gpm)
230 volt 3 phase
 (type power)

(7) electric log (yes or no) no

(organization running log)

(8) how well bottom plugged 4"
back wash w/ve


DRILLERS REMARKS:

RECEIVED
 JAN 30 1987

Department of Natural Resources
 Bureau of Land & Water Resources

If well telescopes please
sketch and show depths.

GROUND LEVEL

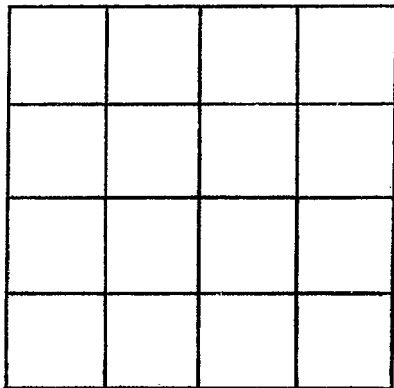

SECTION _____

Please indicate well location X.

ADDITIONAL INFORMATION

If more than one screen,
show locations of each on sketch.