

SIMPSON
 2001
 1-15-77

MISSISSIPPI
 BOARD OF WATER COMMISSIONERS
 416 North State Street
 Jackson, Mississippi 39201

WATER WELL DRILLERS LOG

Jan 15 1977 *Reese Miller* *Simpson*
 date well completed firm name county well located

LANDOWNER:
Mrs. Gay Buckley
Rt. Hebron Miss
 (mailing address)

description of formations encountered	from	to
<i>Red Clay</i>	<i>0</i>	<i>20</i>
<i>White Sand</i>	<i>20</i>	<i>70</i>
<i>sandy gravel</i>	<i>70</i>	<i>85</i>
<i>shale</i>	<i>85</i>	<i>97</i>
<i>sandy pe gravel</i>	<i>97</i>	<i>120</i>

WELL LOCATION:
 sec. *6* T-*10* N R-*19* E
1 miles *SSE* of *Andala*
 (distance) (direction) (nearest town)

WELL PURPOSE: *home*
 (home, irrigation, municipal, industrial)

- WELL COMPLETION DATA:
- (1) diameter (inches) *4"*
 - (2) total depth (feet) *120*
 - (3) static water level (feet) *80* below above top of ground.
 - (4) casing *plastic, bottom* (material) (depth)
 - If telescope see back. (size)
 - (5) screen *6"* *114'* (length) (depth to top)
 - 4"* *plastic* (size) (material)
 - (6) pump *leather* (HP) (yield gpm)
 - elct* (type power)
 - (7) electric log *no* (yes or no)
 - (organization running log)


(8) how well bottom plugged
Woods plug

DRILLERS REMARKS:

RECEIVED
 MAR 21 1977

If well telescopes please sketch and show depths.

GROUND LEVEL

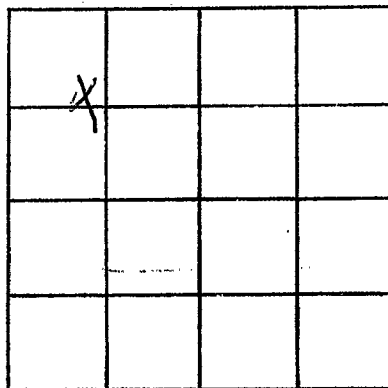

SECTION 6

Please indicate well location X.

ADDITIONAL INFORMATION

If more than one screen, show locations of each on sketch.