

Simpson
 2002
 715177

MISSISSIPPI
 BOARD OF WATER COMMISSIONERS
 416 North State Street
 Jackson, Mississippi 39201

WATER WELL DRILLERS LOG

July 5 1977 date well completed
 47 Dinn Well Service firm name
 Simpson county well located

LANDOWNER: Mr. Herman Lee Shivers, Miss.
 (mailing address)

description of formations encountered

| | from | to |
|---------------|------|-----|
| Top Soil | 0 | 1 |
| clay | 1 | 26 |
| clay + chalc. | 26 | 57 |
| chalk | 57 | 104 |
| SAND | 104 | 145 |

WELL LOCATION:
 sec. 7 T 9 N R 19 E
 S W
 5 miles SE of Shivers
 (distance) (direction) (nearest town)

WELL PURPOSE: Home
 (home, irrigation, municipal, industrial)

WELL COMPLETION DATA:

(1) diameter (inches) 4"

(2) total depth (feet) 145 ft.

(3) static water level (feet) below top of ground.

(4) casing Plastic 135' (material) (depth)
 4" (size) If telescope see back.

(5) screen 10 ft 135' (length) (depth to top)
 4" (size) Plastic (material)

(6) pump 3/4 12 (HP) (yield gpm)
 Elec (type power)

(7) electric log No (yes or no)

(organization running log)

(8) how well bottom plugged B. W. Value


DRILLERS REMARKS:

RECEIVED
 DEC 16 1977

MISS. BD. OF WATER COMM

If well telescopes please
sketch and show depths.

GROUND LEVEL

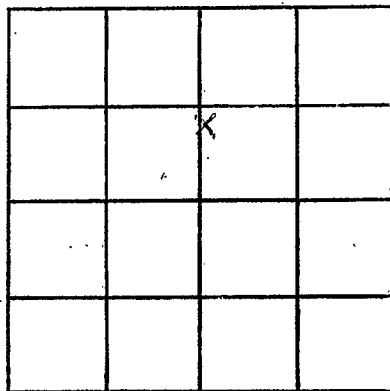

SECTION 2

Please indicate well location X.

ADDITIONAL INFORMATION

If more than one screen,
show locations of each on sketch.