

SIMPSON  
 0 2003  
 12-13-78

MISSISSIPPI  
 BOARD OF WATER COMMISSIONERS  
 416 North State Street  
 Jackson, Mississippi 39201

WATER WELL DRILLERS LOG

TOM GRIFFITH  
 PLUMBING & WELL SERVICE, INC.

*Simpson*  
 county well located

*Nov. 13*  
 date well completed

*(79)*  
 firm name

LANDOWNER:

*Mr. Frank Walker*  
*R.C. Spruitts Job -*  
 (mailing address)

WELL LOCATION:

sec. *31* T *10* N ✓ R *19* E  
 S  
*3* miles *E* of *Shewan*  
 (distance) (direction) (nearest town)

WELL PURPOSE:

(home, irrigation, municipal, industrial)

WELL COMPLETION DATA:

- (1) diameter (inches) *2"*
- (2) total depth (feet) *190 ft.*
- (3) static water level (feet) *120 ft.* below top of ground.
- (4) casing *plastic 170 ft.*  
 (material) (depth)  
*2"*  
 (size) If telescope see back.
- (5) screen *20 ft., 170 ft.*  
 (length) (depth to top)  
*2"*, *plastic*  
 (size) (material)
- (6) pump *1 1/2 HP, 7*  
 (HP) (yield gpm)  
*Electric*  
 (type power)
- (7) electric log *No*  
 (yes or no)

(organization running log)

- (8) how well bottom plugged *Back wash valve*

DRILLERS REMARKS:

description of formations encountered

from to

|                          |            |            |
|--------------------------|------------|------------|
| <i>Top Soil</i>          | <i>0</i>   | <i>2</i>   |
| <i>Clay</i>              | <i>2</i>   | <i>8</i>   |
| <i>Sand</i>              | <i>8</i>   | <i>21</i>  |
| <i>Gravel</i>            | <i>21</i>  | <i>36</i>  |
| <i>Chalk</i>             | <i>39</i>  | <i>90</i>  |
| <i>Sand</i>              | <i>90</i>  | <i>107</i> |
| <i>Gravel &amp; Sand</i> | <i>107</i> | <i>141</i> |
| <i>Sand</i>              | <i>141</i> | <i>190</i> |


Miss. Board of Water Comm.

FEB 23 1979

RECEIVED

If well telescopes please sketch and show depths.

GROUND LEVEL

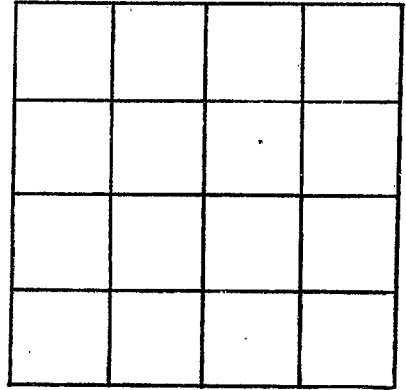

SECTION \_\_\_\_\_

Please indicate well location X.

ADDITIONAL INFORMATION

If more than one screen,  
show locations of each on sketch.