

Simpson
 Ⓟ 2004
 Mar. 27, 1979

MISSISSIPPI
 BOARD OF WATER COMMISSIONERS
 416 North State Street
 Jackson, Mississippi 39201

WATER WELL DRILLERS LOG

March 27
 date well completed

TOM GRIFFITH
 PUMPING & WELL SERVICE, INC.
 320 MAYSON AVE.
 COLUMBIA, MS 39202

Simpson
 county well located

LANDOWNER: Mr. Bill Bradford
Penola, Miss.
 (mailing address)

description of formations encountered	from	to
<u>Top soil</u>	<u>0</u>	<u>2</u>
<u>Clay</u>	<u>2</u>	<u>8</u>
<u>Sand</u>	<u>8</u>	<u>39</u>
<u>Gravel</u>	<u>39</u>	<u>67</u>
<u>Chalk</u>	<u>62</u>	<u>102</u>
<u>Sand</u>	<u>102</u>	<u>185</u>

WELL LOCATION: 19
 sec. 8 T. 10 N. R. # 4
7 miles SE of Penola
 (distance) (direction) (nearest town)

WELL PURPOSE: Home
 (home, irrigation, municipal, industrial)

- WELL COMPLETION DATA:
- (1) diameter (inches) 4"
 - (2) total depth (feet) 185 ft.
 - (3) static water level (feet) 14 ft. below top of ground.
 - (4) casing plastic 165 ft.
 (material) (depth)
4"
 (size) if telescope see back.
 - (5) screen 20 ft. 165 ft.
 (length) (depth to top)
4" plastic
 (size) (material)
 - (6) pump 1/2 hp 12 gpm.
 (HP) (yield gpm)
Electric
 (type power)
 - (7) electric log No
 (yes or no)

(organization running log)

(8) how well bottom plugged
Back wash valve

DRILLERS REMARKS:


Miss. Board of Water Comm.

JUL 5 1979

RECEIVED

If well telescopes please sketch and show depths.

GROUND LEVEL

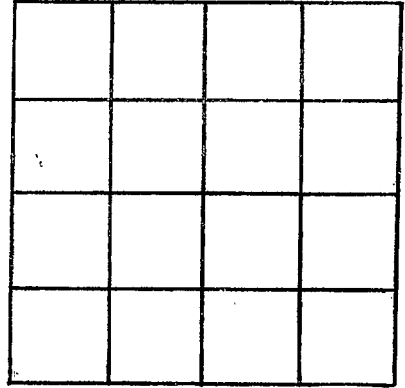

SECTION _____

Please indicate well location X.

ADDITIONAL INFORMATION

If more than one screen,
show locations of each on sketch.