

Simpson

SIMPSON

2005

1/16/79

Jan. 16 1979

date well completed

MISSISSIPPI BOARD OF WATER COMMISSIONERS
 416 North State Street
 Jackson, Mississippi 39201

WATER WELL DRILLERS LOG

TOM GRIFFITH
 PLUMBING & WELL SERVICE, INC. Simpson
 firm name county well located

LANDOWNER:
 Mrs. Rosta Bethen
 Shivers, Miss.
 (mailing address)

WELL LOCATION:
 sec. 23 T 10 N R 18 E
 S W
 6 miles E of Shivers
 (distance) (direction) (nearest town)

WELL PURPOSE: Home
 (home, irrigation, municipal, industrial)

- WELL COMPLETION DATA:**
- (1) diameter (inches) 2"
 - (2) total depth (feet) 210 ft.
 - (3) static water level (feet) 140 ft. below top of ground.
 - (4) casing plastic 190 ft. (material) (depth)
 2" (size) If telescope see back.
 - (5) screen 20 ft. 190 ft. (length) (depth to top)
 2" (size) plastic (material)
 - (6) pump 1 H.P. 10 (HP) (yield gpm)
 Electric (type power)
 - (7) electric log No (yes or no)
- (organization running log)

(8) how well bottom plugged
 B.W. Valve

DRILLERS REMARKS:

description of formations encountered	from	to
Top Soil	0	2
Clay	2	10
Gravel	10	18
Sand	18	49
Chalk	49	91
Sand	91	140
Chalk	140	172
Sand	172	210


Miss. Board of Water Comm.

MAY 4 1979

RECEIVED

If well telescopes please sketch and show depths.

GROUND-LEVEL

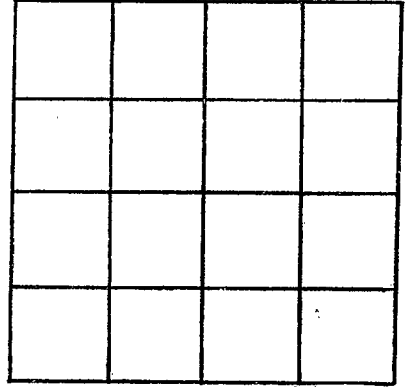

SECTION _____

Please indicate well location X.

ADDITIONAL INFORMATION

If more than one screen,
show locations of each on sketch.