

SIMPSON
 0 2000
 04-11-79

MISSISSIPPI
 BOARD OF WATER COMMISSIONERS
 416 North State Street
 Jackson, Mississippi 39201

WATER WELL DRILLERS LOG

4-11-1979 *Greene Drilling Simpson*
 date well completed firm name county/well located

LANDOWNER:
Pratt Production
1515 Capital Towers
Jackson, Ms.
 (mailing address)

description of formations encountered	from	to
<i>Clay + sand streaked</i>	<i>0</i>	<i>168</i>
<i>rock and gravel</i>	<i>168</i>	<i>210</i>
<i>sand + gravel</i>	<i>210</i>	<i>231</i>
<i>clay + sand</i>	<i>231</i>	<i>329</i>
<i>sand</i>	<i>329</i>	<i>618</i>
<i>clay</i>	<i>618</i>	<i>669</i>
	<i>669</i>	<i>672</i>

WELL LOCATION: *1500' N + 1140' E*
 sec. *8* T. *10* N R. *19* E of *SW/4*
Hwy 13 + Hwy 28
 (distance) (direction) (nearest town)

WELL PURPOSE: *oil field*
 (home, irrigation, municipal, industrial)

WELL COMPLETION DATA:

(1) diameter (inches) *3"*

(2) total depth (feet) *672'*

(3) static water level (feet) *180'* *below* above top of ground.

(4) casing *672' steel*
 (material) (depth)

3" if telescope see back.
 (size)

(5) screen *42'* *630'*
 (length) (depth to top)

3" *perforated*
 (size) (material)

(6) pump *75*
 (HP) (yield gpm)

AC
 (type power)

(7) electric log *yes*
 (yes or no)

(organization running log)

(8) how well bottom plugged *orange peel*

DRILLERS REMARKS:


Miss. Board of Water Comm.

MAY 9 1979

RECEIVED

If well telescopes please sketch and show depths.

GROUND LEVEL

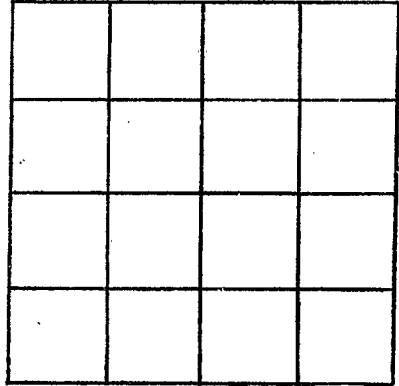

SECTION _____

Please indicate well location X.

ADDITIONAL INFORMATION

If more than one screen, show locations of each on sketch.