

Simpson
02007

MISSISSIPPI DEPARTMENT OF NATURAL RESOURCES
 Bureau of Land and Water Resources
 Southport Mall
 P.O. Box 10631

Jackson, Mississippi 39209

WATER WELL DRILLERS LOG

Griner Drilling Service, Inc.

Simpson

3-17-82
 date well completed

Griner Drilling Service, Inc.
 firm name

Simpson
 county well located

LANDOWNER:
Transcontinental Oil Corp.
1700 Capital Towers
Jackson, Ms. 39205
 (mailing address)

description of formations encountered

from

to

sand, pea gravel

0

160

clay

160

190

WELL LOCATION: 1500' N & 1400' W

sand, pea gravel

190

315

pc 35 T 10 S R 19 E SE 10 W

No. 1 the Oak Grove Field
 Both 10 miles of (distance) (direction) (nearest town)

WELL PURPOSE: oil field supply
 (home, irrigation, municipal, industrial)

WELL COMPLETION DATA:

(1) diameter (inches) 3"

(2) total depth (feet) 315'

(3) static water level (feet) 80' below above top of ground.

(4) casing steel, 315'
 (material) (depth)

3" if telescope see back.
 (size)

(5) screen 42', 273'
 (length) (depth to top)

3", perforated
 (size) (material)

(6) pump —, 80-85
 (HP) (yield gpm)

AC
 (type power)

(7) electric log (yes or no) —

(organization running log)

(8) how well bottom plugged orange
peel

DEPT. OF NATURAL RESOURCES
 BUREAU OF LAND & WATER RESOURCES


MAR 26 1982

DRILLERS REMARKS:

RECEIVED

If well telescopes please
sketch and show depths.

GROUND LEVEL

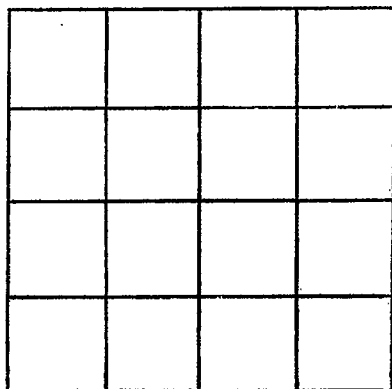

SECTION _____

Please indicate well location X.

ADDITIONAL INFORMATION

If more than one screen,
show locations of each on sketch.