

MISSISSIPPI DEPARTMENT OF NATURAL RESOURCES

Bureau of Land and Water Resources

Southport Mall

P.O. Box 10631

Jackson, Mississippi 39209

WATER WELL DRILLERS LOG

AA

Simpson
 Φ 2008

9-26-86 19 date well completed
 Jim Griffith Well Service firm name
 Simpson county well located

LANDOWNER: <u>Alvin Roberts</u> <u>1781, Box 100</u> <u>Prentiss, MS</u> (mailing address)	description of formations encountered	from	to
	CLAY	0	15
	SAND	15	185
WELL LOCATION: sec <u>36</u> T <u>10</u> S R <u>19</u> E <u>MAGEE</u> <u>10</u> miles <u>SW</u> of <u>Prentiss</u> (distance) (direction) (nearest town)			
WELL PURPOSE: <u>Home</u> (home, irrigation, municipal, industrial)			
WELL COMPLETION DATA:			
(1) diameter (inches) <u>2"</u>			
(2) total depth (feet) <u>185</u>			
(3) static water level (feet) <u>50'</u> below above top of ground.			
(4) casing <u>PVC</u> <u>185'</u> (material) (depth)			
<u>2"</u> (size) if telescope see back.			
(5) screen <u>20'</u> <u>185'</u> (length) (depth to top)			
<u>2"</u> <u>PVC</u> (size) (material)			
(6) pump <u>1-1/2 HP</u> <u>35 gpm</u> (HP) (yield gpm)			
<u>Electric</u> <u>12 pump</u> (type power)			
(7) electric log <u>no</u> (yes or no)			
<u>NA</u> (organization running log)			
(8) how well bottom plugged <u>BWV</u>			
DRILLERS REMARKS:			


RECEIVED

SEP 24 1987

Department of Natural Resources
 Bureau of Land & Water Resources

If well telescopes please sketch and show depths.

GROUND LEVEL

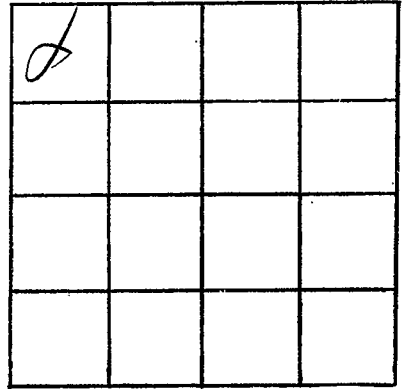

SECTION 36

Please indicate well location X.

ADDITIONAL INFORMATION

If more than one screen, show locations of each on sketch.