

# MISSISSIPPI DEPARTMENT OF NATURAL RESOURCES

Bureau of Land and Water Resources

P.O. Box 10631

Jackson, Mississippi 39209

## WATER WELL DRILLERS LOG

COUNTY WELL LOCATED <b>Simpson</b>	
WELL NUMBER <b>Φ</b>	CODED
DATE WELL COMPLETED <b>2011 6-13-90</b>	

PERMIT NUMBER
NAME OF DRILLING FIRM <b>Roy D. West</b>

NAME & MAILING ADDRESS OF LANDOWNER <b>Todd Dupree Rt 2 Box 37 Collins, MS 39428</b>		
WELL LOCATION: SEC	TOWNSHIP	RANGE
<b>23</b>	<b>10<sup>N</sup></b>	<b>19<sup>E</sup></b>
DISTANCE	DIRECTION	NEAREST TOWN
<b>10</b> Miles	<b>W</b>	of <b>Magice</b>
OTHER LANDMARK		
WELL PURPOSE: <input checked="" type="radio"/> Home, <input type="radio"/> Irrigation, <input type="radio"/> Municipal, <input type="radio"/> Industrial, <input type="radio"/> Fish Pond, etc.		

PUMP DATA		
PUMP TYPE (Circle One): <input checked="" type="radio"/> Submersible, <input type="radio"/> Turbine, <input type="radio"/> Jet <input type="radio"/> Flowing Well, Other (Describe) _____		
POWER TYPE (Circle One): <input checked="" type="radio"/> Electric, <input type="radio"/> Tractor, <input type="radio"/> Diesel, <input type="radio"/> Gasoline, <input type="radio"/> Butane, Other (Describe) _____ H/P <b>1</b>		
Pump Capacity (GPM)	No. of Stages	Setting Depth
<b>20</b>		<b>120'</b> FT.
PUMP TEST		
Well yielded _____ GPM with a drawdown of _____ ft. after _____ hours of pumping		

WELL DATA		
Well Depth <b>150'</b>	Casing Diameter (In.) <b>4"</b>	Casing Length (Ft.) <b>140'</b>
Type of Casing <b>PVC</b>	Hole Depth <b>150'</b>	Depth to Static Water Level <b>80'</b>
TYPE OF COMPLETION: (Circle One or More): <input checked="" type="radio"/> Gravel Packed, <input type="radio"/> Underreamed, <input type="radio"/> Telescoped, <input checked="" type="radio"/> Natural Development, <input type="radio"/> Open Hole, <input type="radio"/> Other (Describe) _____		
Top of Lap Pipe or Reduction in Casing		
FEET <input type="checkbox"/> IF TELESCOPED OR MORE THAN ONE SCREEN: USE BACK PAGE		

LOG DATA	
TYPE OF LOG RUN (Circle One): Electric, Gamma Ray, Density, Sonic, Neutron, Other (Describe) _____	
<input checked="" type="radio"/> No Log Run	
Name of Organization Running Log	

SCREEN DATA		
Diameter - Inches <b>4"</b>	Length - Feet <b>10'</b>	Slot Size - Inches <b>.010</b>
Screen Type <b>PVC</b>	Depth to Bottom - Feet <b>150'</b>	


GEOLOGIC DATA (Office Use Only)			
Surface Elev.	Geologic Unit	Unit Thickness	Depth to Top
Subs. SWL	Date	Analysis	Aquifer Test

Driller's Remarks
-------------------

DESCRIPTION OF FORMATIONS ENCOUNTERED	FROM	TO	FORMATIONS (Continued) FROM TO
<b>SANDY CLAY</b>	<b>0</b>	<b>6</b>	<div style="text-align: right; font-size: 2em; font-weight: bold; opacity: 0.5;">RECEIVED</div> <div style="text-align: center; font-size: 1.5em; font-weight: bold;">JUL 03 1990</div> <div style="text-align: center; font-weight: bold;">Department of Natural Resources Bureau of Land &amp; Water Resources</div>
<b>CLAY</b>	<b>6</b>	<b>15</b>	
<b>CLAY GRAVEL</b>	<b>15</b>	<b>65</b>	
<b>SILTY SAND &amp; GRAVEL</b>	<b>65</b>	<b>135</b>	
<b>COARSE SAND</b>	<b>135</b>	<b>150</b>	
IF MORE SPACE IS NEEDED, USE BACK			

If well telescopes please  
sketch and show depths.

GROUND LEVEL

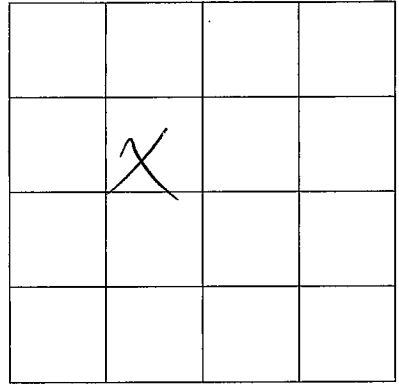

SECTION 23

Please indicate well location X.

ADDITIONAL INFORMATION

If more than one screen,  
show location of each on sketch.