

Simpson
P2
Jan-12-68

MISSISSIPPI
BOARD OF WATER COMMISSIONERS
416 North State Street
Jackson, Mississippi 39201 CODED

WATER WELL DRILLERS LOG

19 W. H. Dellar & Son, Simpson

date well completed _____ firm name _____ county well located _____

LANDOWNER: Chivers

(mailing address)

WELL LOCATION:
sec. 11 T. 20 N. R. 5 E 18 W
3 miles W of Maple
(distance) (direction) (nearest town)

description of formations encountered	from	to
<u>Chalk & Clay</u>	<u>0</u>	<u>14'</u>
<u>Red sand</u>		<u>42</u>
<u>gravel & Rock</u>		<u>60</u>
<u>Water sand</u>		<u>20</u>
		<u>25</u>

WELL PURPOSE:
(home, irrigation, municipal, industrial)

- WELL COMPLETION DATA:
- (1) diameter (inches) _____
 - (2) total depth (feet) _____
 - (3) static water level (feet) _____ below above top of ground.
 - (4) casing _____ (material), _____ (depth), _____ (size) if telescope see back.
 - (5) screen 12ft (length), _____ (depth to top)
1/4 8 slot S steel (size), _____ (material)
 - (6) pump 1 1/2 (HP), _____ (yield gpm)
Elect (type power)
 - (7) electric log _____ (yes or no)


(organization running log)
 - (8) how well bottom plugged _____

DRILLERS REMARKS: _____

CODED
MAY 20 1968
MISS. Bd. OF WATER COMM.

If well telescopes please sketch and show depths.

GROUND LEVEL

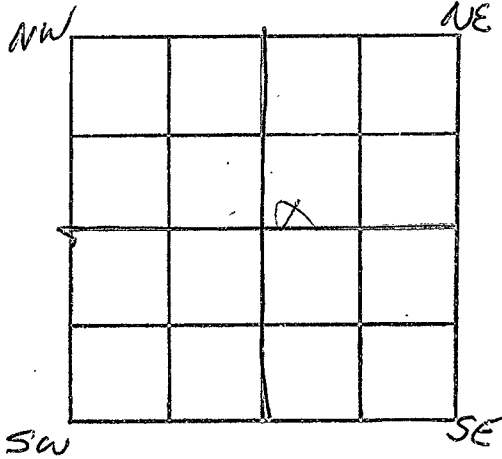

SECTION 11

Please indicate well location X.

ADDITIONAL INFORMATION

If more than one screen, show locations of each on sketch.