

SIMPSON
P3
10 66

MISSISSIPPI
BOARD OF WATER COMMISSIONERS
416 North State Street
Jackson, Mississippi 39201

CODED

WATER WELL DRILLERS LOG

Oct. 5-66 19 W.H. Dalbey Small Basin SIMPSON
date well completed firm name county well located


LANDOWNER:
Cleveland Durr
Rt. Magazine
(mailing address)
WELL LOCATION:
sec 25 T 10 N R 18 E
5 miles S of Mag
(distance) (direction) (nearest town)

description of formations encountered	from	to
	<u>Clay & Chalk</u>	<u>0</u>
<u>Sand & gravel</u>	<u>83</u>	<u>104</u>
<u>Water Pond</u>	<u>104</u>	<u>138</u>

WELL PURPOSE:
(home, irrigation, municipal, industrial)


WELL COMPLETION DATA:
(1) diameter (inches) 2 in.
(2) total depth (feet) 138
(3) static water level (feet) 104 below top of ground.
(4) casing NONE
(material) (depth)
_____ if telescope see back.
(size)
(5) screen 10 ft 2 ft
(length) (depth to top)
1/4 8 slot
(size) (material)
(6) pump 3/4 _____
(HP) (yield gpm)
(type power)
(7) electric log No
(yes or no)
(organization running log)
(8) how well bottom plugged _____

DRILLERS REMARKS:

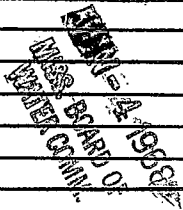

If well telescopes please sketch and show depths.

GROUND LEVEL

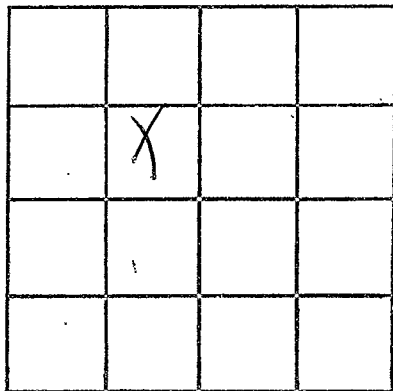

SECTION _____

Please indicate well location X.

ADDITIONAL INFORMATION

If more than one screen, show locations of each on sketch.