

CODED

CODED

CODED

Simpson  
 P 13  
 2-69

MISSISSIPPI  
 BOARD OF WATER COMMISSIONERS  
 416 North State Street  
 Jackson, Mississippi 39201

WATER WELL DRILLERS LOG

Feb 7 1969 date well completed  
 Simpson firm name  
 county, well located


LANDOWNER:	description of formations encountered	from	to
R. E. ... (mailing address)			
WELL LOCATION: sec. 14 T. 10 N R. 12 W 3 miles S.W. of ... (distance) (direction) (nearest town)			
WELL PURPOSE: (home, irrigation, municipal, industrial)			
WELL COMPLETION DATA:			
(1) diameter (inches) 2"			
(2) total depth (feet) 180'			
(3) static water level (feet) 122' below top of ground.			
(4) casing (material) 1 1/2" (depth) 128'			
2" (size) if telescope see back.			
(5) screen 12" (length) 118' (depth to top)			
2" (size) (material)			
(6) pump 2 (HP) 750 (yield gpm)			
out (type power)			
(7) electric log (yes or no)			
(organization running log)			
(8) how well bottom plugged			
DRILLERS REMARKS:			

LOI/EE CODED

MAR 19 1969  
 MISS. Bd. OF WATER COM.

If well telescopes please sketch and show depths.

GROUND LEVEL

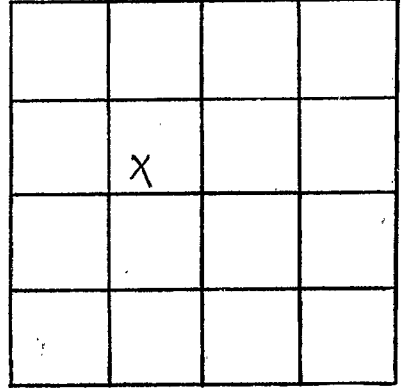

SECTION 14

Please indicate well location X.

ADDITIONAL INFORMATION

If more than one screen,  
show locations of each on sketch.