

Simpson
P 14.
3-27-69

MISSISSIPPI
 BOARD OF WATER COMMISSIONERS
 416 North State Street
 Jackson, Mississippi 39201

CODED

WATER WELL DRILLERS LOG

427 19*69* *D. E. Simpson* *Simpson*
 date well completed firm name county well located

LANDOWNER:
Levitt R. Walker
Simpson Miss.
 (mailing address)

WELL LOCATION:
 sec. *4* T. *10* N. R. *18* E
4 miles *W* of *Maguer*
 (distance) (direction) (nearest town)

description of formations encountered	from	to
<i>Uniform coarse</i>	<i>0</i>	<i>15</i>
<i>Sandstone</i>	<i>15</i>	<i>110</i>
<i>Shale</i>	<i>110</i>	<i>160</i>
<i>White sand</i>	<i>160</i>	<i>181</i>

WELL PURPOSE: *Home*
 (home, irrigation, municipal, industrial)

WELL COMPLETION DATA:

(1) diameter (inches) *2"*

(2) total depth (feet) *181'*

(3) static water level (feet) *110* below/above top of ground.

(4) casing *Galv.* *175'*
 (material) (depth)
2" If telescope see back.
 (size)

(5) screen *6'* *175'*
 (length) (depth to top)
2" *S. S. Gravel*
 (size) (material)

(6) pump *Rock* *4*
 (HP) (yield gpm)
 (type power)

(7) electric log *no*
 (yes or no)
 (organization running log)

(8) how well bottom plugged *W/Seal*

CODED


APR 2 1969

MISS. BD. OF
 WATER COMM.

DRILLERS REMARKS:

If well telescopes please sketch and show depths.

GROUND LEVEL

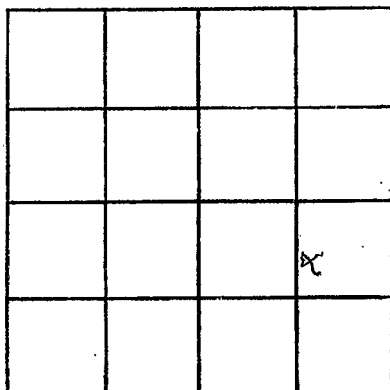

SECTION 74

Please indicate well location X.

ADDITIONAL INFORMATION

If more than one screen,
show locations of each on sketch.