

Q P 18

12-7-65

WATER WELL DRILLERS LOG

**CODED**

Date: 12/17, 1965, Driller: Forest Drilling County Simpson  
 (Name)

(1) Owner of Land:	Description & Color of Materials Sand, Clay, Red Clay, Shell, etc.	Thick- ness Feet	Depth Feet
<u>Sam Sparks</u> (Name) <u>Orange, Miss</u> (Address) <u>1018</u>	<u>Red Clay</u>		<u>20</u>
(2) Location: <u>1/4</u> , <u>1/4</u> , Sec. <u>T</u> , <u>R</u> , <u>4</u> miles <u>South</u> of <u>Orange</u> (distance) (direction) (Nearest Town) <u>west of Hwy 49</u>	<u>Sand</u> <u>Gravel &amp; Sand</u> <u>Rock &amp; Sand</u> <u>Gravel &amp; Sand</u>		<u>122</u> <u>172</u> <u>192</u> <u>222</u>
(3) Topography: (Hilly) (Flat) (Level)			
(4) Purpose of Well: <u>Home</u> (Domestic Irrigation Municipal, Industrial, Other)			

**CODED**

Information upon completion of well:

(1) Diameter 2 inches.

(2) Total Depth 222 feet.

(3) Water Level 110 feet below top of ground.

(4) Cased to 207, Size 2"


(5) Screen: Size 2", Length 15 ft

(6) Were any formations sealed against pollution?  
 \_\_\_\_\_ yes,  no.

If YES depth of formation \_\_\_\_\_

Why \_\_\_\_\_

Drillers Remarks: \_\_\_\_\_

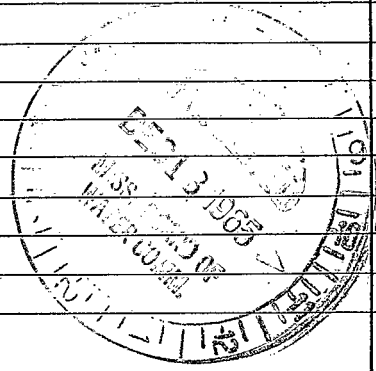

(Use Back Side)

Well No.

