

SIMPSON
P20

10/80

10/80

MISSISSIPPI
BOARD OF WATER COMMISSIONERS
416 North State Street
Jackson, Mississippi 39201

CODED

WATER WELL DRILLERS LOG

GRINER DRILLING SERVICE SIMPSON

date well completed

firm name

county well located

LANDOWNER: NEW HOPE

description of formations encountered

from

to

WATER ASSOCIATION,

TOP SOIL

0

3

CLAY

3

14

WELL NO. 2

SAND & GR. CRUST

14

258

(mailing address)

CLAY

258

278

WELL LOCATION: NE 1/4 SE 1/4 NE 1/4

sec. 26 T. 10 N. R. 18 E. S. W.

miles (distance) of (direction) of (nearest town)

WELL PURPOSE: FURROW W.A.
(home, irrigation, municipal, industrial)

WELL COMPLETION DATA:

CODED

- (1) diameter (inches) 12"
- (2) total depth (feet) 252'
- (3) static water level (feet) 104.3' below top of ground.

- (4) casing steel 202' (material) (depth)
12 3/4" (size) if telescope see back.

- (5) screen 40' 210' (length) (depth to top)
8" 304 S.S. (size) (material)

- (6) pump 20 250 (HP) (yield gpm)
Elect. (type power)

- (7) electric log Yes. (yes or no)
Miss. Geol. Survey. (organization running log)

- (8) how well bottom plugged BACK
WASH VALVE

DRILLERS REMARKS:


DEPT. OF NATURAL RESOURCES
BUREAU OF LAND & WATER RESOURCES

OCT 28 1980

RECEIVED

telescopes please
sketch and show depths.

GROUND LEVEL

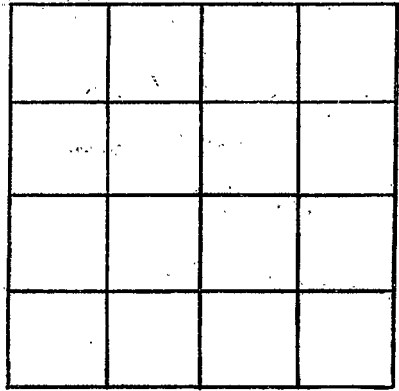

SECTION _____

Please indicate well location X.

ADDITIONAL INFORMATION

If more than one screen,
show locations of each on sketch.