

MISSISSIPPI DEPARTMENT OF NATURAL RESOURCES

Bureau of Land and Water Resources

Southport Mall

P.O. Box 10631

Jackson, Mississippi 39209

WATER WELL DRILLERS LOG

Griner Drilling Service, Inc.

Simpson

SIMPSON
P 21
1/23/83

1-21-83
date well completed

Griner Drilling Service, Inc.
firm name

Simpson
county well located

LANDOWNER:
Transcontinental Oil
1700 Capital Towers
Jackson, Ms. 39201
(mailing address)

description of fomations encountered

from

to

SAND, ped gravel 0 160

CLAY 160 190

WELL LOCATION: 2640' N of 1200' E
sec 31 T 10N R 18E SW/40
no. 1
Bobby Oak Grove Field
Jones (distance) miles of (direction) (nearest town)

SAND, ped gravel 190 273

WELL PURPOSE: oil field supply
(home, irrigation, municipal, industrial)

WELL COMPLETION DATA:

- (1) diameter (inches) 3"
- (2) total depth (feet) 273'
- (3) static water level (feet) 80' below top of ground.
- (4) casing steel 273' (material) (depth)
3" (size) if telescope see back.
- (5) screen 42' 231' (length) (depth to top)
3" perforated (size) (material)
- (6) pump — 75 (HP) (yield gpm)
AC (type power)

CODED

(7) electric log (yes or no)

(organization running log)

(8) how well bottom plugged Orange
peel

DRILLERS REMARKS:


DEPT. OF NATURAL RESOURCES
BUREAU OF LAND & WATER RESOURCES

JAN 31 1983

RECEIVED

If well telescopes please sketch and show depths.

GROUND LEVEL

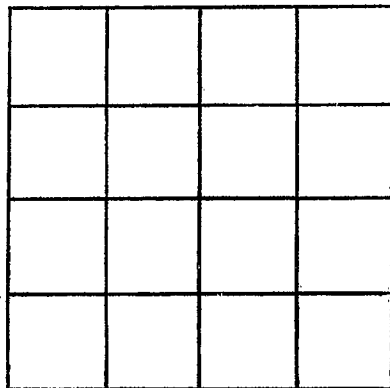

SECTION _____

Please indicate well location X.

ADDITIONAL INFORMATION

If more than one screen, show locations of each on sketch.