

640008-01
GW 12798

Q E Log 111

SIMPSON

~~P15~~ 24

4-70

MISSISSIPPI
BOARD OF WATER COMMISSIONERS
416 North State Street
Jackson, Mississippi 39201

CODED

WATER WELL DRILLERS LOG

April 19 70 Robert E. Ratliff Simpson
date well completed firm name county well located

LANDOWNER: New Hope Water Assn.

description of formations encountered

from to

Clay

0 40

Gravel

40 100

Clay

100 160

Sand

160 264

Simpson County

(mailing address)

WELL LOCATION:

sec. 20 T. 10 S. R. 17 E. 36 10 N 18 W
3 miles South of McGee
(distance) (direction) (nearest town)

WELL PURPOSE: Community
(home, irrigation, municipal, industrial)

WELL COMPLETION DATA:

- (1) diameter (inches) 10" x 6"
- (2) total depth (feet) 260
- (3) static water level (feet) 109 below top of ground.
- (4) casing Blk Stl 200' (material) (depth) 10" (size) if telescope see back.
- (5) screen 60' (length) 260' (depth to top) 6" S.S. (size) (material)
- (6) pump 20 (HP) 240 (yield gpm) Elec. (type power)
- (7) electric log Yes (yes or no) (organization running log)
- (8) how well bottom plugged Back Press. Valve

CODED

P15 was P15A, P15B, P15C, & P15D. P15D was made into the production well & called P24 by the GS.

AUG 6 1970

DRILLERS REMARKS:


Test well to 1102' (1969)

MISS. BD. OF WATER COMMISSIONERS

0

If well telescopes please sketch and show depths.

GROUND LEVEL

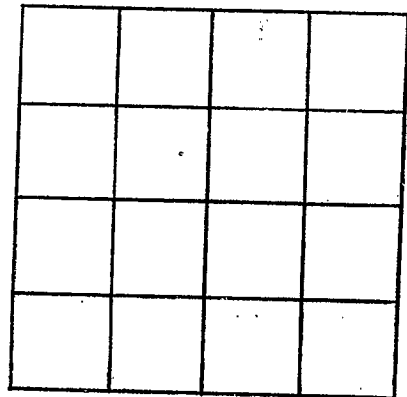

SECTION _____

Please indicate well location X.

ADDITIONAL INFORMATION

Lined area for providing additional information, consisting of approximately 25 horizontal lines.

If more than one screen, show locations of each on sketch.