

MISSISSIPPI DEPARTMENT OF NATURAL RESOURCES

Bureau of Land and Water Resources

Southport Mall

P.O. Box 10631

Jackson, Mississippi 39209

WATER WELL DRILLERS LOG

Simpson
P25

Griner Drilling Service, Inc.

Simpson

3-28-91
date well completed

firm name

county well located

Lease: No. 1 POC Paramount - Valdez - Walker et al 11-7-9

LANDOWNER:
Mid South Drilling Co.
4213 ISS North
Suite 101
Jackson, Ms. 39206
(mailing address)

description of formations encountered	from	to
<u>clay, sand and pea gravel</u>	<u>0</u>	<u>80</u>

WELL LOCATION: 1600'S & 1500'W
sec. 11 T. 10 (N) R. 18 E of
Magee
(distance) miles (direction) (nearest town)

<u>sand and pea gravel</u>	<u>80</u>	<u>200</u>
----------------------------	-----------	------------

WELL PURPOSE: oilfield rig
(home, irrigation, municipal, industrial)

WELL COMPLETION DATA:

(1) diameter (inches) 4"

(2) total depth (feet) 200'

(3) static water level (feet) 97' below above top of ground.

(4) casing PVC, 170'
(material) (depth)

4" if telescope see back.
(size)

(5) screen 20', 170' to 190'
(length) (depth to top)

4", PVC screen
(size) (material)

(6) pump 7 1/2, 60
(HP) (yield gpm)

230 volt 3 phase
(type power)

(7) electric log (yes or no)
(organization running log)

(8) how well bottom plugged 4" PVC backwash valve

DRILLERS REMARKS:


RECEIVED

MAY 10 1991

Dept. of Environmental Quality
Bureau of Land & Water Resources

If well telescopes please
sketch and show depths.

GROUND LEVEL

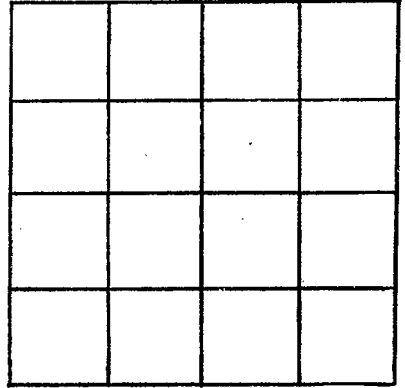

SECTION _____

Please indicate well location X.

ADDITIONAL INFORMATION

If more than one screen,
show locations of each on sketch.