

MISSISSIPPI
BOARD OF WATER COMMISSIONERS
416 North State Street
Jackson, Mississippi 39201

WATER WELL DRILLERS LOG

Seiperson
P 2000
2-68

July 2 19*68* *Buddy Dallas* *Well*
date well completed firm name county well located

LANDOWNER: *Bennet Prince*
Magee Miss.

description of formations encountered	from	to
<i>red clay</i>	<i>0</i>	<i>25</i>
<i>red sand</i>	<i>25</i>	<i>40</i>
<i>chalk</i>	<i>40</i>	<i>52</i>
<i>sand & gravel</i>	<i>52</i>	<i>77</i>
<i>Water sand</i>	<i>77</i>	<i>110</i>

(mailing address)
WELL LOCATION:
sec. *6* T. *10* S. R. *18* E
1 1/2 miles *W* of *Magee*
(distance) (direction) (nearest town)

WELL PURPOSE:
(home, irrigation, municipal, industrial)

- WELL COMPLETION DATA:
- (1) diameter (inches) *2 in*
 - (2) total depth (feet) *110*
 - (3) static water level (feet) *50* below above top of ground.
 - (4) casing *plastic* *60*
(material) (depth)
6 in if telescope see back.
(size)
 - (5) screen *6 ft*
(length) (depth to top)
1/4 *stainless steel*
(size) (material) *3/8 in*
 - (6) pump *1*
(HP) (yield gpm)

(type power)
 - (7) electric log *No*
(yes or no)


(organization running log)
 - (8) how well bottom plugged

DRILLERS REMARKS:

WELL LOG
DATE
1968

If well telescopes please sketch and show depths.

GROUND LEVEL

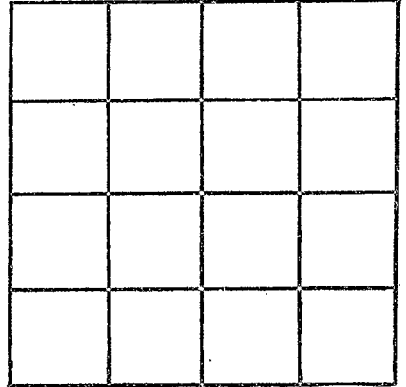

SECTION _____

Please indicate well location X.

ADDITIONAL INFORMATION

If more than one screen, show locations of each on sketch.